


DATE _____

TOWN OF LEXINGTON — BOARD OF PUBLIC WORKS

WATER DIVISION

Sketch of Service Here

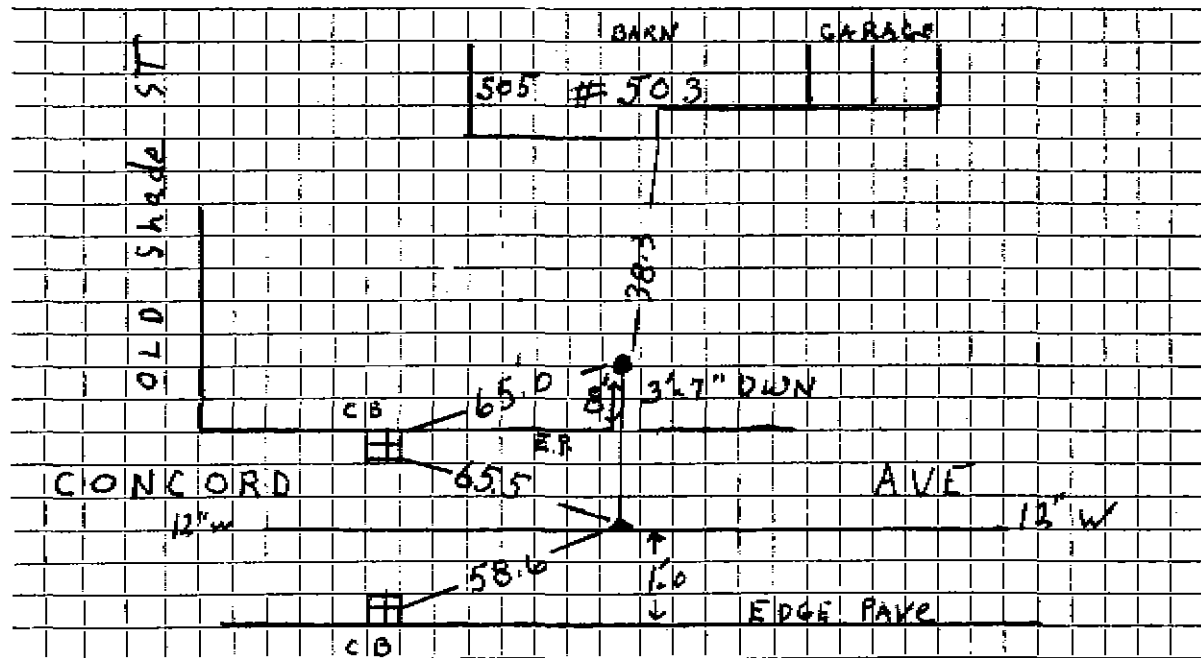

Connection made in Concord Ave Street. Work completed Aug. 2002

Remarks:
.....
.....