




**TOWN OF LEXINGTON — BOARD OF PUBLIC WORKS**  
**WATER DIVISION**

Sketch of Service Here  
CONCORD AVE

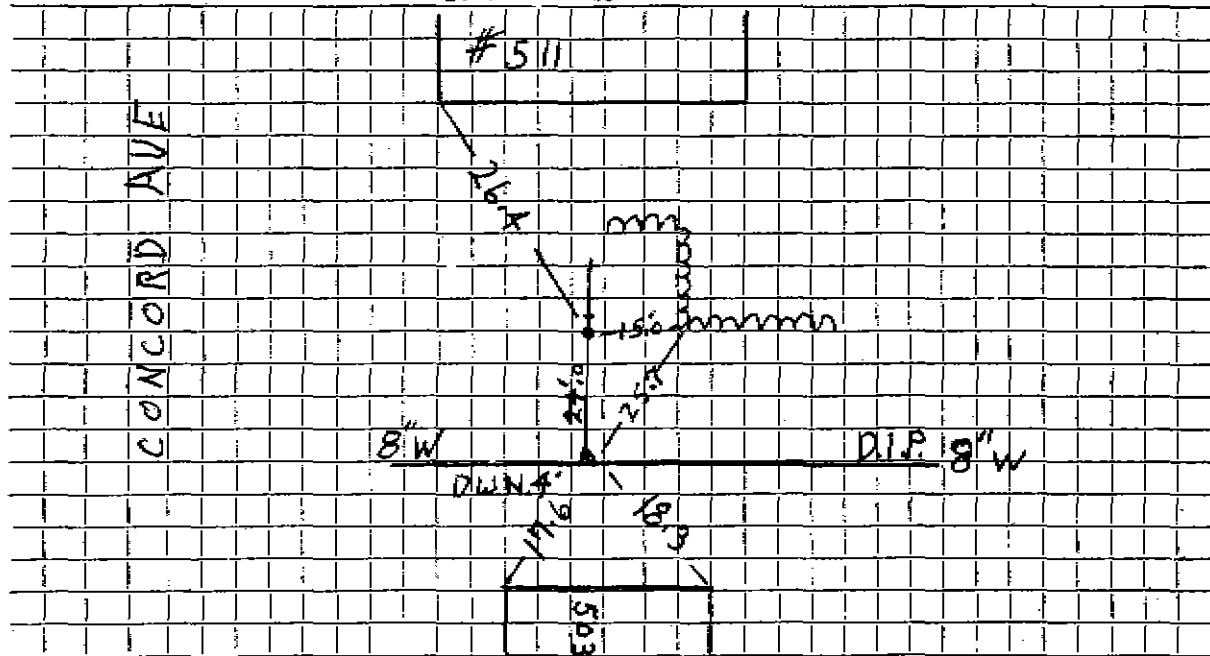

Connection made in OLD Shade ST Street. Work completed 2002 Dec 1

Remarks: \_\_\_\_\_  
\_\_\_\_\_  
\_\_\_\_\_