

WATER SERVICE RECORD

Name John D. Woodfin, Jr.

Service No. 9

Address 517 Concord Avenue

Location

Repair ~~Other~~ ~~General~~ New Service

Com. 3-21-55


Date	Material	Amount	Total	Date	Amount
3/2/55	Labor	10 10		1-13-55 Deposited	80 00
	10% overhead	1 01	11 11	3-21-55 Refunded	10 84
	58' - 3/4" copper tubing@.35	20 30			NON CHARGE
	1 - 3/4" C x 3/4" I.W.H. stop & waste	4 00		3/2/55 Labor	10 10
	4 hrs. Littlefield shovel@7.50	30 00		6' - 3/4" copper tubing@.35	2 10
	1 hr. trucking		75	1 - 3/4" C. corp-cock	4 33
	patching 3 x 3		3 00	1 - 3/4" C. curb-cock	4 67
			69 16	1 box and rod	3 90
				1 - 1/2" offset tail pc.	50
				1 - 1/2" straight ta'l pc.	50
				2/3 hrs. Littlefield shovel@7.50	5 00
				1 hr. trucking	75
					31 85

DATE _____

TOWN OF LEXINGTON — BOARD OF PUBLIC WORKS

WATER DIVISION

Sketch of Service Here

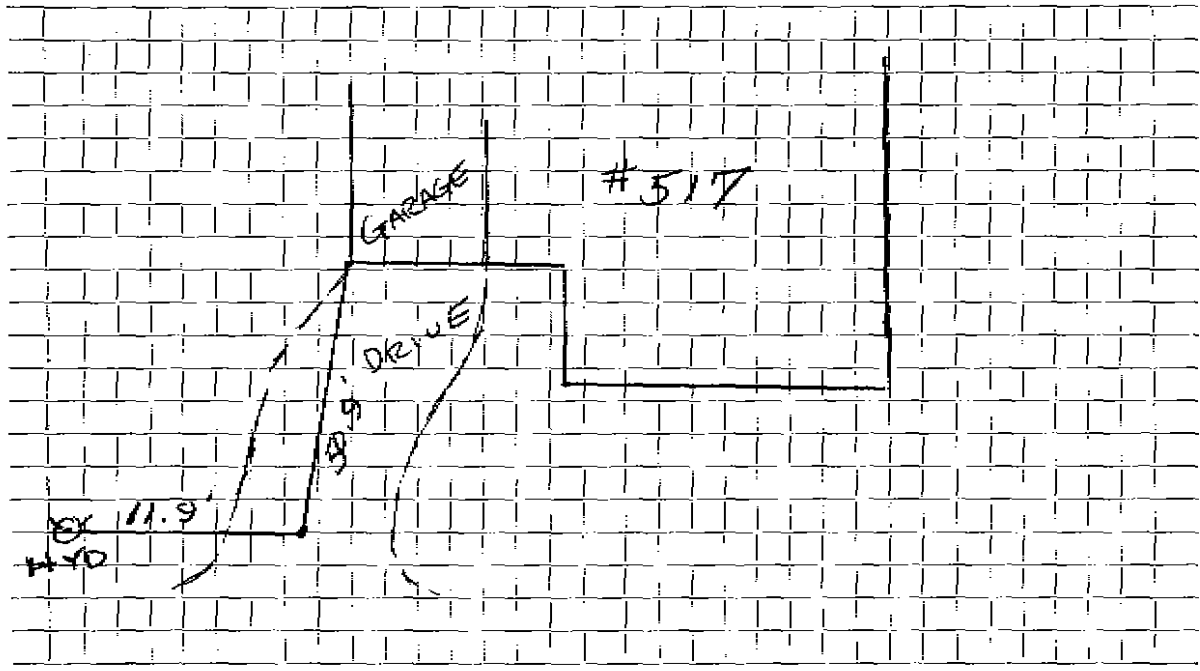

Connection made in Street. Work completed

Remarks:
.....
.....