

WATER SERVICE RECORD

#3689

Name W. L. Collins

Service No. 279

Address 535 Concord Avenue

Location Lexington

Repair ~~XXXXXX~~ - New Service

*C.M. 11-24-52*


Date	Material	Amount	Total	Date	Amount
10/27/52	Labor	1 63		10-22-52	50 -
	10% overhead	16	1 79	11-24-52	(19 36)
	55' - 3/4" copper tubing@ .34		18 70		NON CHARGE
	1 -3/4" C x 1/2 I.W.H. stop& waste		4 00	10/27/52	Labor
	1 hr. trucking		75		6' - 3/4" copper tubing@ .34
	patching 5 x 3		5 00		1 -3/4" C. corp-cock
			30 24		1 - 3/4" C x 3/4" C. curb-cock
					1 box and rod
	TRENCH DUG BY OWNER				1 - 1/2 offset tail piece
					1 - 1/2 straight tail piece
					2 hrs. Littlefield shovel
					1 hr. trucking
					40 82

DATE \_\_\_\_\_

TOWN OF LEXINGTON — BOARD OF PUBLIC WORKS

**WATER DIVISION**

Sketch of Service Here

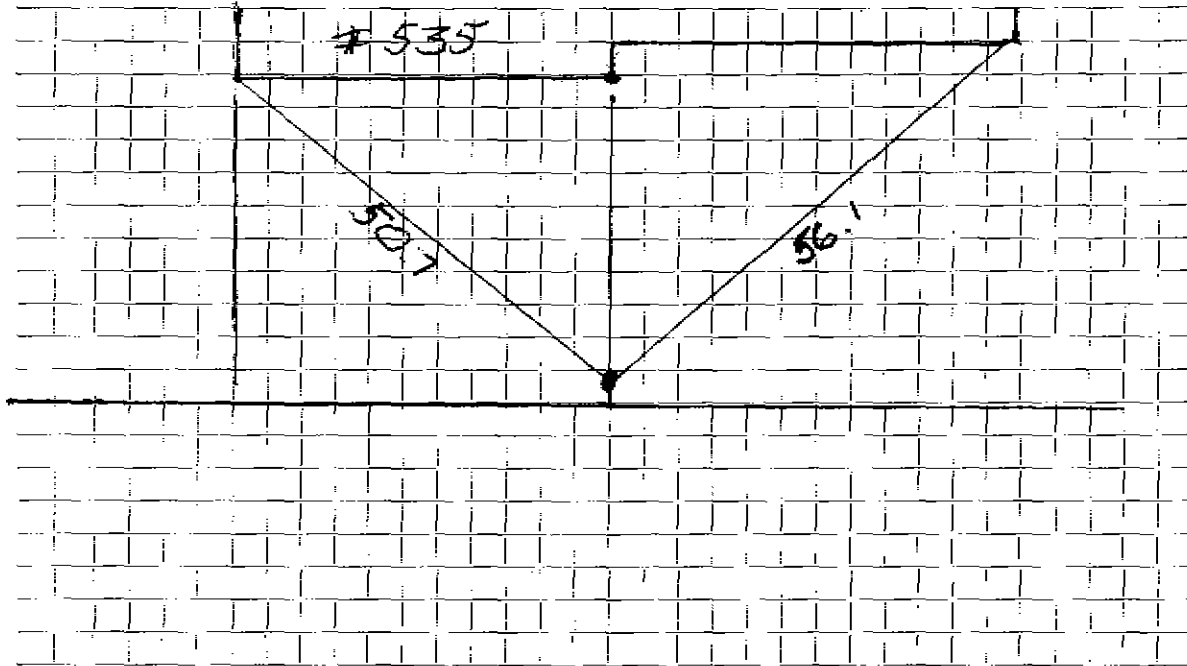

Connection made in ..... Street.                      Work completed .....

Remarks: .....

.....

.....