

WATER SERVICE RECORD

Name Vincent Lombardi

Service No. 286

Address 539 Concord Ave.

Location

Repair ~~XXXXXX~~ - New Service

Com 12-31-54


Date	Material	Amount	Total	Date	Amount
12/8/54	Labor	11 78		11-16-54	Deposited 75 00
	10% overhead	1 18	12 96	12-31-54	Refunded 8 79
	60' - 3/4" copper tubing @ .35	21 00			NON CHARGE 66 21
	1 - 3/4"C x 1/2 I.W.H. stop & waste	4 00		12/8/54	Labor 11 78
	3 2/3 hrs. Littlefield shovel	7.50	27 50		12' - 3/4" copper tubing @ .35 4 20
	1 hr. trucking		75		1 - 3/4"C. corp-cock 4 33
			66 21		1 - 3/4"C. curb-cock 4 67
					1 box and rod 3 90
					1 - offset tail pc. 50
					1 - straight tail pc. 50
					1 hr. Littlefield shovel 7 50
					1 hr. trucking 75
					38 13

DATE _____

TOWN OF LEXINGTON — BOARD OF PUBLIC WORKS

WATER DIVISION

Sketch of Service Here

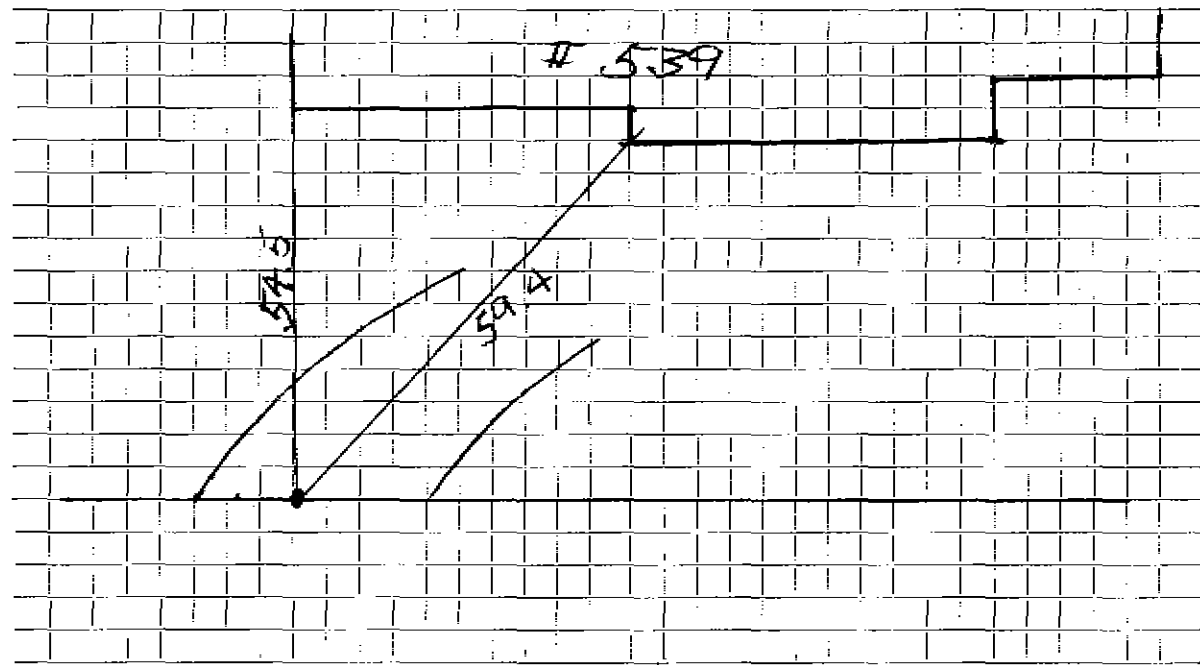

Connection made in Street. Work completed

Remarks:
.....
.....