

WATER SERVICE RECORD

Name Edward A. Cuertara

Service No.

#1709
#1770
169

Address 546 Concord Ave.

Location Lexington, Mass.

Repair ~~Renewal~~ New Service

Com 9-29-52


Date	Material	Amount	Total	Date	Amount
8/28/52	Labor	7 05		8-12-52	Deposited 75 00
	10% overhead	71	7 76	9-29-52	Refunded 4 49
	50' - 3/4" copper tubing @ .34		17 00		NON CHARGE 70 51
	1 - 3/4" C x 1/2 I.W.H. stop&waste		4 00	11/7/51	Labor 9 02
	3 hrs. Littlefield shovel @ 7.00		21 00		28' - 3/4" copper tubing@.326 9 12
	1 hr. trucking		75		1 - 3/4" C. corp-cock 4 33
					1 - 3/4" C x 3/4" C. curb-cock 4 67
					1-box and rod 4 68
11/7/51	patching 20 x 3	20 00	20 00		XXXXXXXXXXXXXXXXXXXXXXXXXXXXXXXX 50
			70 51		XXXXXXXXXXXXXXXXXXXXXXXXXXXXXXXX 50
					4 hrs. Littlefield shovel@7.00 2800
					1 hr. trucking 75
					6057
				8/28/52	Labor 7 05
					1 - 1/2 offset tail piece 50
					1 - 1/2 straight tail piece 50
					TOTAL 69 62
					68 62

DATE _____

TOWN OF LEXINGTON — BOARD OF PUBLIC WORKS

WATER DIVISION

Sketch of Service Here

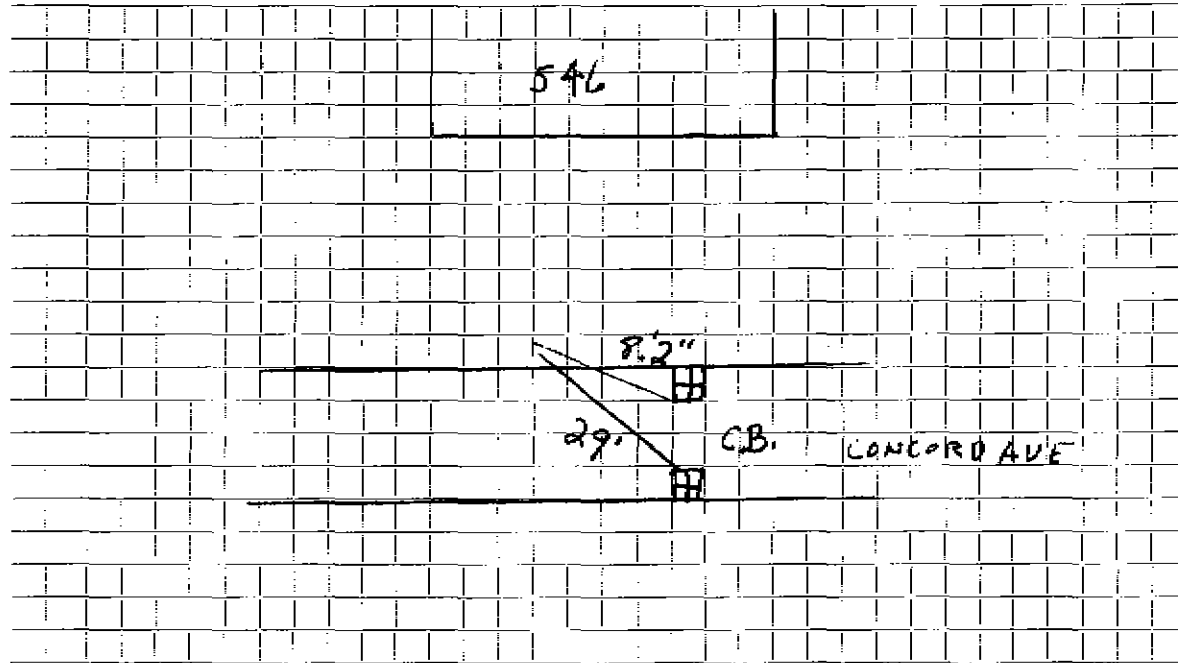

Connection made in Street. Work completed

Remarks :

.....

.....