

WATER SERVICE RECORD

Name William J. Hamilton, Jr.

Service No. 42

Address 558 Concord Avenue

#7320

Location

Repair ~~Renewal~~ New Service Valeri #1995
~~XXXXXXXXXXXX~~ W. O. # 8326


APR 26 1972

Date	Material	Amount	Total	Date	Amount
1/7/72	Labor	166.99		12-3-71	350.00
4/5/72	"	47.14			8.67
	10% O.H.	21.41	235.54	5-5-72	358.67
	26' 3/4" Copper pipe .79		20.54		
	1 3/4" Corporation		9.57		
	1 3/4" Curb cock		11.32		
	1/2 Ton Cold patch 8.00		4.00		
	1 Box & Rod		7.60		
	3 Ton Hot Top 7.45		22.35		
	4 Hrs. Trucking 3.00		12.00		
	1/2 Hr. " 1.50		75		
	3 Hrs. Shovel 6.50		19.50		
	2 1/2 Hrs. Compressor 5.00		12.50		
	1/2 Hr. Roller 2.00		1.00		
	Trailer		2.00		
1-11-72	57' 3/4" Copper tubing		358.67		

DATE _____

TOWN OF LEXINGTON — BOARD OF PUBLIC WORKS
WATER DIVISION

Sketch of Service Here

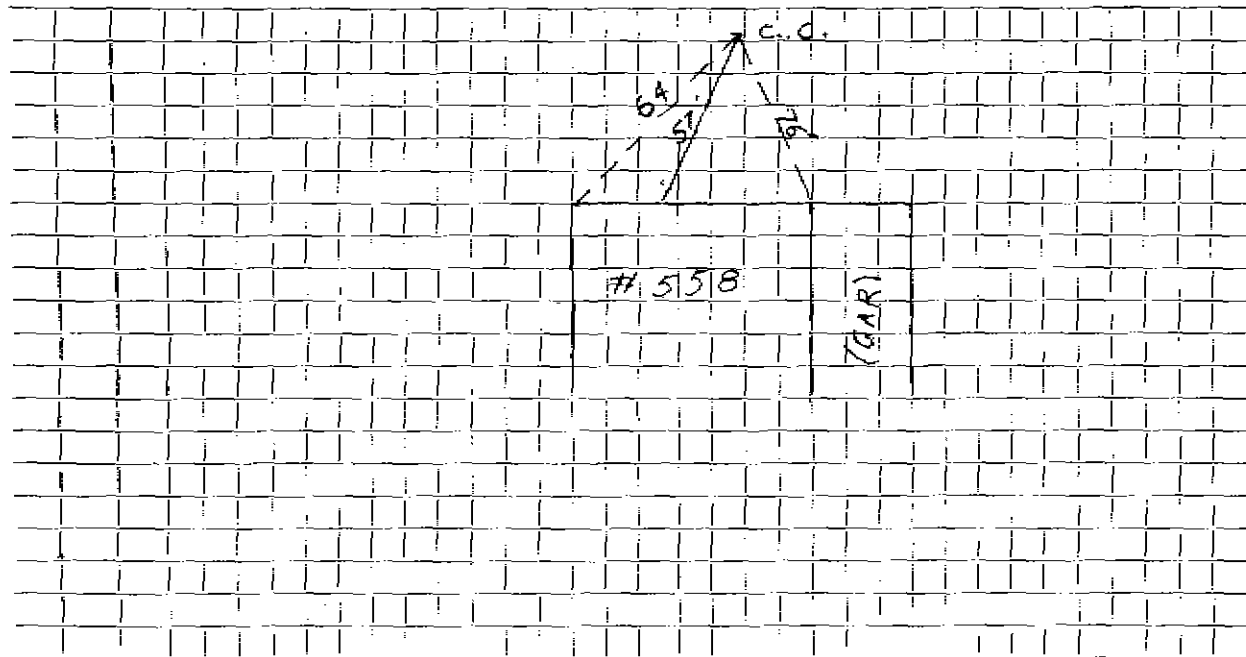

Connection made in Street. Work completed

Remarks:

.....
.....