

## WATER SERVICE RECORD

Name William Hamilton, Jr.

Service No. 43

Address 560 Concord Avenue

Location

~~Replaced~~ ~~Renewal~~ - New Service W. O. # 8327 *Valley #1994*


APR 26 1972

Date	Material	Amount	Total	Date	Amount
12/9/71	Labor	95 64		1-10-72	350 00
4/5/72	"	47 14		4-24-72	49 81
10%	O.H.	14 28	157 06		280 19
26'	3/4" Copper pipe .79		20 54		
1	3/4" Corporation		9 57		
1	3/4" Curb Cock		11 32		
	Box & Rod		7 60		
1/2	Ton cold patch 8.00		4 00		
3	" hot top 7.45		22 35		
4	Hrs. trucking 3.00		12 00		
1/2	" " 1.50		75		
2 1/2	Hrs. Compressor 5.00		12 50		
3	Hrs. Shovel 6.50		19 50		
1/2	Hr. Roller 2.00		1 00		
	Trailer		2 00		
			2 80 19		
1-11-72	75' 3/4" Copper tubing				

DATE \_\_\_\_\_

**TOWN OF LEXINGTON — BOARD OF PUBLIC WORKS**  
**WATER DIVISION**

Sketch of Service Here

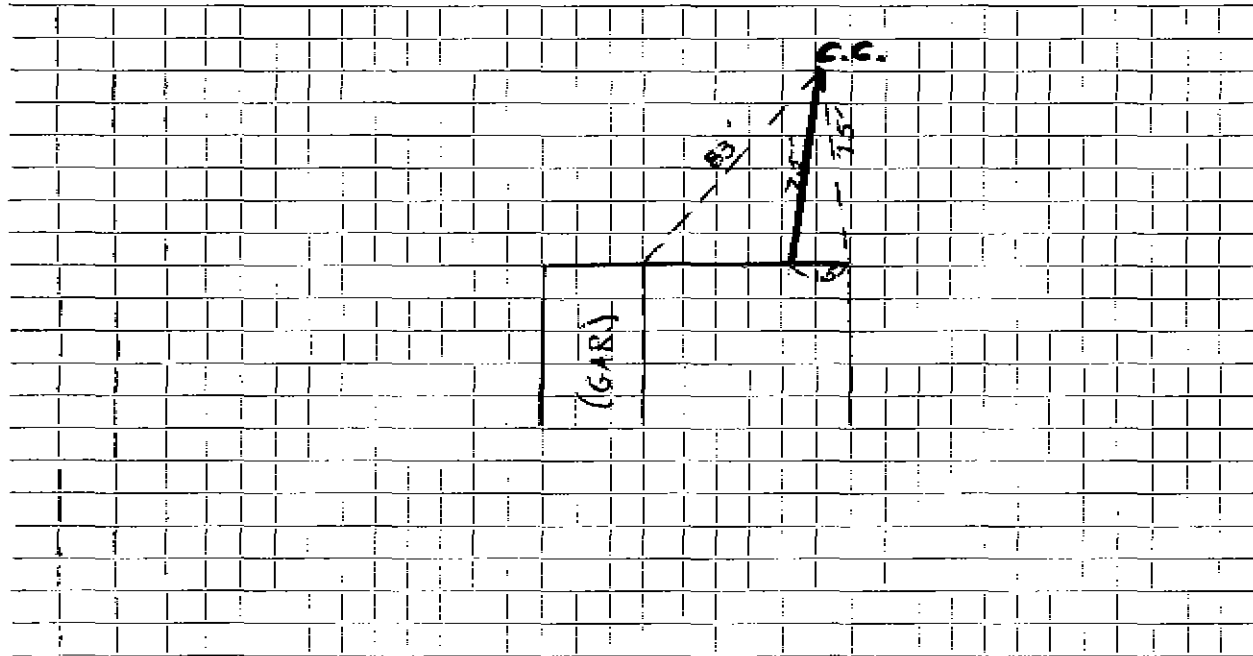

Connection made in ..... Street. Work completed .....

Remarks: .....

.....

.....