

WATER SERVICE RECORD

Name Stephen W. Hamilton

Service No. 28

Address 562 Concord Avenue

Location

~~Repair/Replace~~ New Service

WO# 3357. *Hamilton #2705*

*Comm 7-28-75*


Date	Material	Amount	Total	Date	Amount
5-28-75	Labor	15.48		<i>5-26-75</i>	<i>Deposit</i>
	"	<u>81.12</u>	96.60	<i>7-28-75</i>	<i>Retrad</i>
	10 % O.H.	<u>9.66</u>	\$106.26		
7	Tons Gravel	@2.20	15.40		
1	Patch 4' x 7'		18.66		
1	Patch 5' x 8'		21.64		
1	Hr. Trucking	@3.00	3.00		
2	Hrs. Backhoe	@6.50	13.00		
1	Hr. Compressor		5.00		
			\$182.96		
<i>6/3/75</i>	<i>358'</i> <i>1 1/2"</i> Copper tubing				
	<i>58'</i> <i>1"</i> Copper tubing				

DATE \_\_\_\_\_

TOWN OF LEXINGTON — BOARD OF PUBLIC WORKS

**WATER DIVISION**

Sketch of Service Here

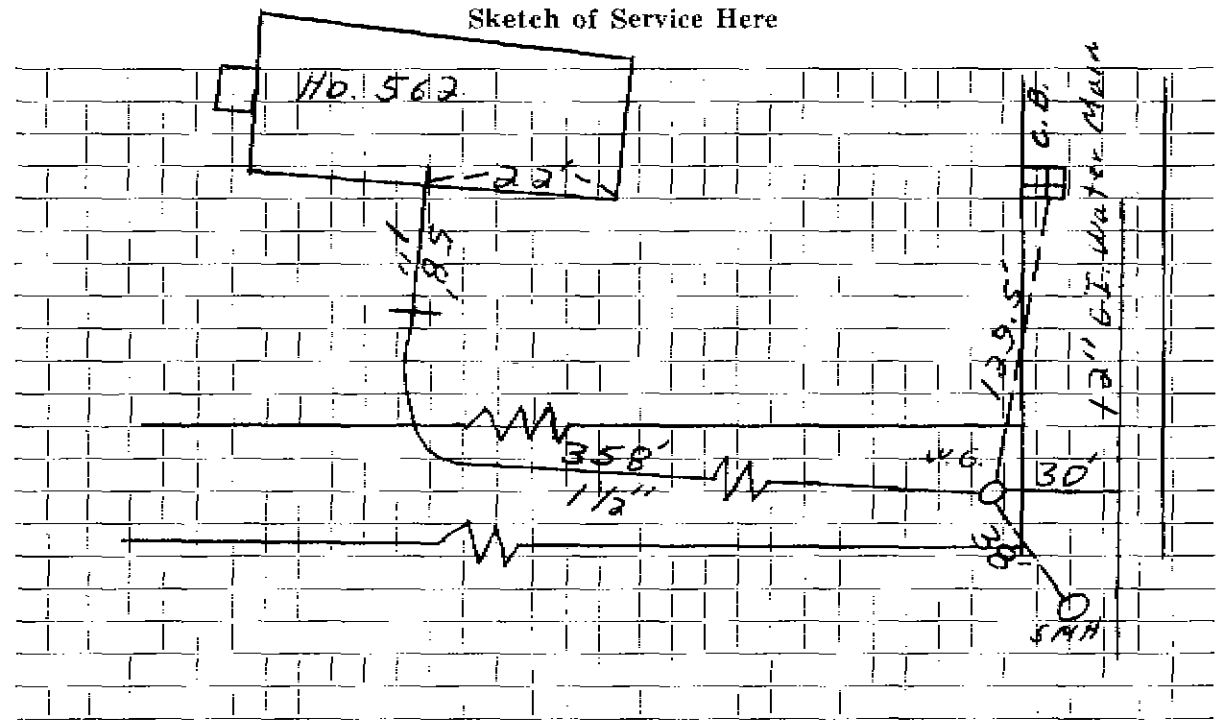

Connection made in ..... Street.                      Work completed .....

Remarks: .....  
.....  
.....