

## WATER SERVICE RECORD

Name Stephen W. Hamilton

Service No. 29

Address 564 Concord Avenue

Location

~~Repair - Renewal~~ New Service WO#3358

Hamilton # 2726

Comm 7-28-75


Date	Material	Amount	Total	Date	Amount
5-28-75	Labor	15.48		5-16-75	500.00
5-29-75	"	81.12	96.60	7-28-75	10.99
	10% O.H.	9.66	\$106.26		18.91
7	Tons Gravel	@2.20	15.40		
$\frac{1}{2}$	Ton Cold Patch		3.05		
1	Patch 4' x 7'		18.66		
1	Patch 5' x 8'		21.64		
2	Hrs. Trucking	@3.00	6.00		
2	Hrs. Backhoe	@6.50	13.00		
1	Hr. Compressor		5.00		
			\$189.01		
6/3/75	225' $1\frac{1}{2}$ " Copper tubing				
	116' 1" Copper tubing				

DATE \_\_\_\_\_

TOWN OF LEXINGTON — BOARD OF PUBLIC WORKS

**WATER DIVISION**

Sketch of Service Here

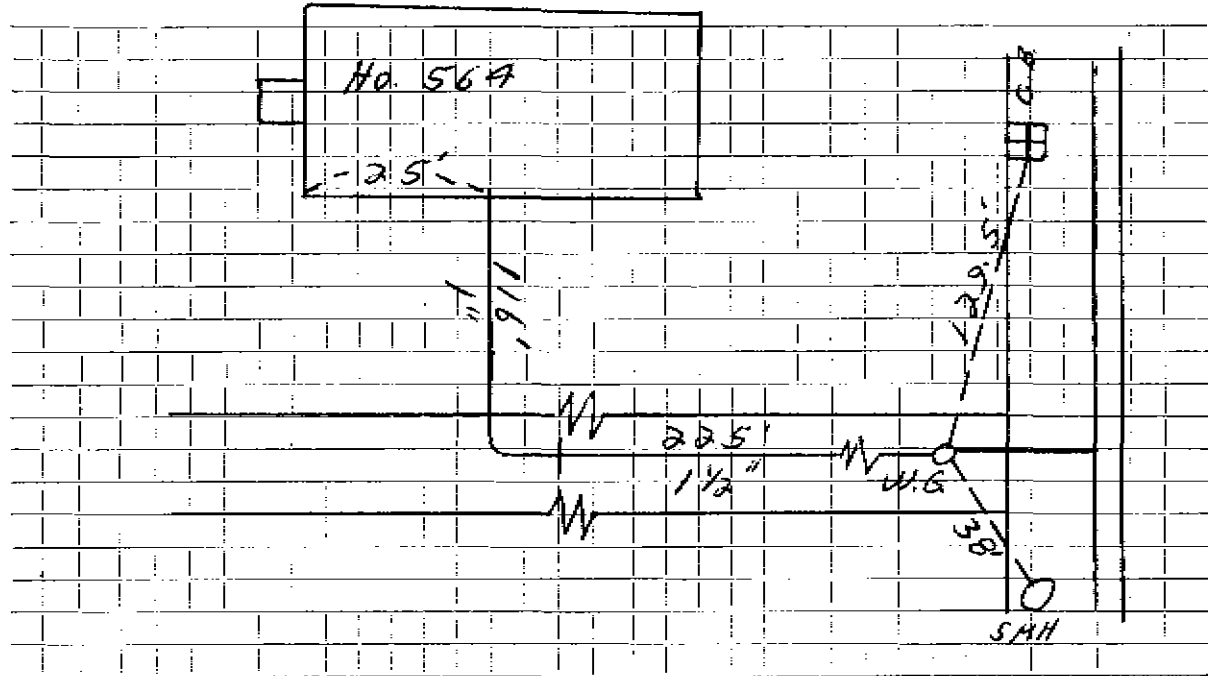

Connection made in ..... Street. Work completed .....

Remarks: .....  
.....  
.....