

WATER SERVICE RECORD

Name *Robert Phelan*

Service No.

Address 571 Concord Avenue


Location

~~Repairxx Renewal~~—New Service Redmond #4401

DATE _____

TOWN OF LEXINGTON — BOARD OF PUBLIC WORKS

WATER DIVISION

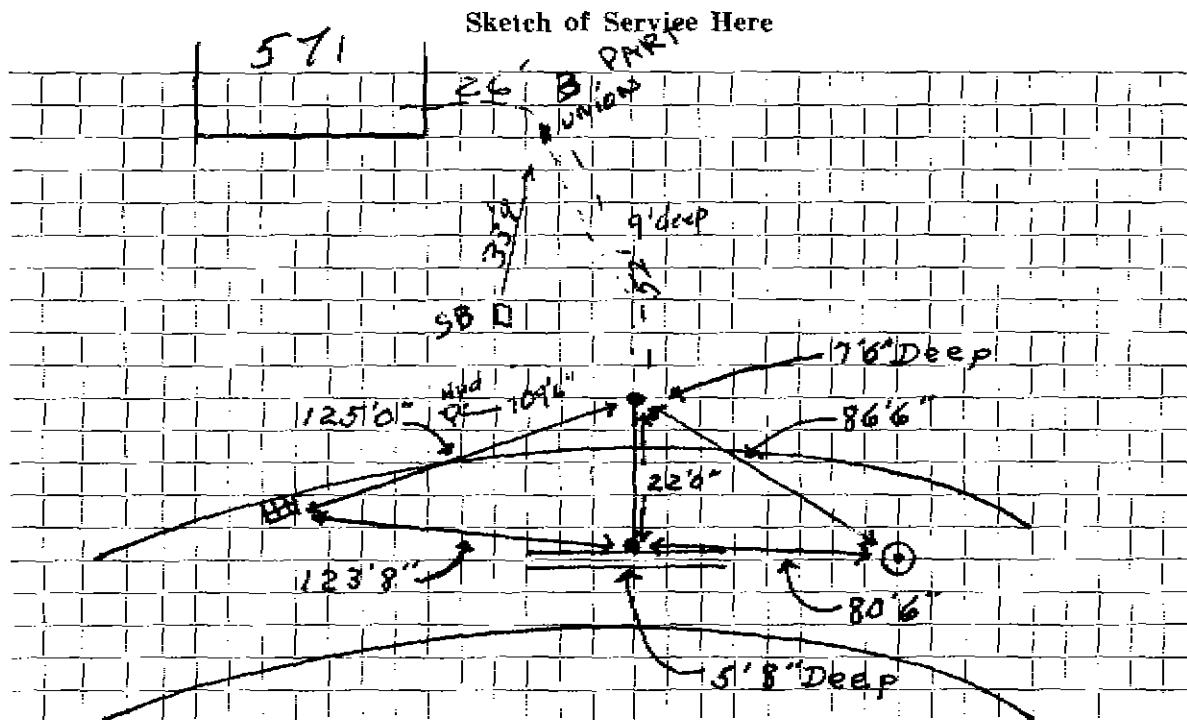

Connection made in CONCORD AVE..... Street.

Work completed

Remarks: