

WATER SERVICE RECORD

Name Philip Heidke

326-4199

Service No. 12

Address 575 Concord Avenue

Location

~~REPAIR RECORD~~ - New Service W.O. #6325 Eagle #3327

SEP 25 1978


| Date | Material | Amount | Total | Date | Amount |
|---------|------------------------|--------|--------|---------|----------------|
| 6-8-78 | Labor | 43.62 | | 5-24-78 | Deposit 180.00 |
| | 10% O.H. | 4.36 | 47.98 | 9-25-78 | Refund 101.54 |
| 23' | 1" Copper tubing @.90 | | 20.70 | | 178.46 |
| 1 | 1" Corp. | | 17.96 | | |
| 1 | 1" Curb | | 21.98 | | |
| 1 | Box & Rod | | 11.00 | | |
| 1/2 | ton Cold Patch | | 7.37 | | |
| 1 1/2 | hr. Trucking @3.00 | | 4.50 | | |
| 1 1/2 | hrs. Town Shovel @6.50 | | 9.75 | | |
| | Hot Top 4' x 14' | | 37.32 | | |
| | | | 178.46 | | |
| 6/30/78 | 181' 1" Copper tubing | | | | |

DATE _____

TOWN OF LEXINGTON — BOARD OF PUBLIC WORKS

WATER DIVISION

Sketch of Service Here

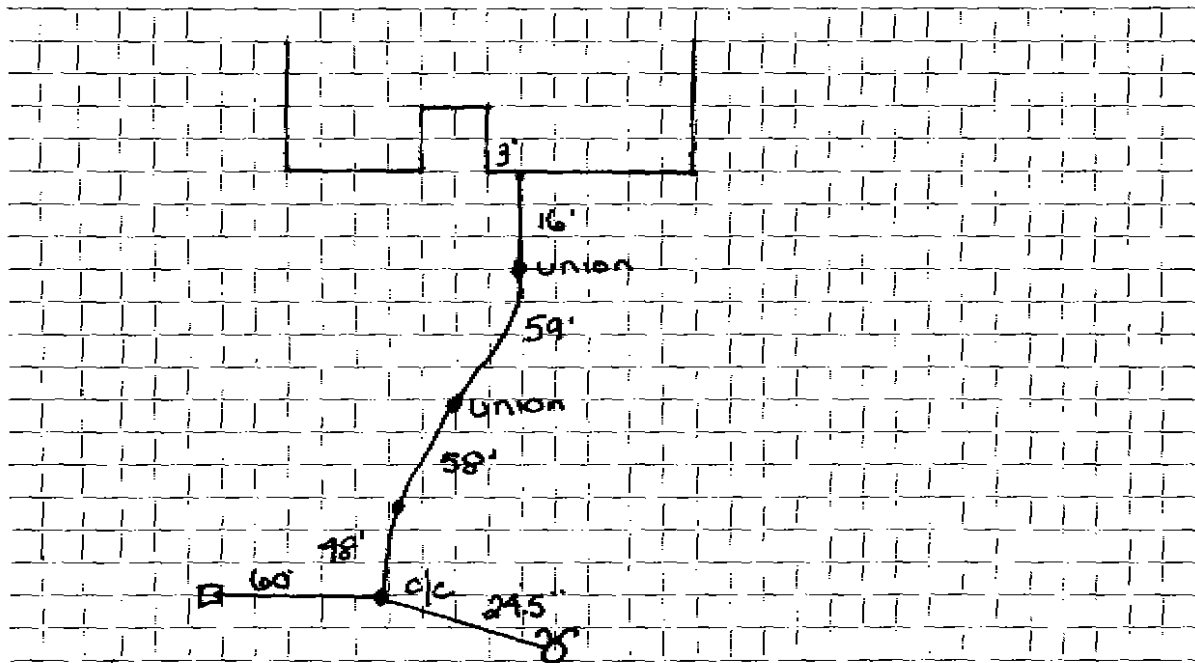

Connection made in Concord Ave Work completed

Remarks:

.....

.....