

SERVICE TIES

CONCORD AVE - PROPOSED WATER PLAN.

382, 404, 426 411, 429, 435

440, 464, 476 447, 461, 473

475, 481, 485

489, 501, 503

511 - TAP ON SHADE ST

2 BARBERRY RD

SPRING ST PROPOSED WATER

16, 18, 20, 22, 24 23, 27, 31, 35, 41, 43

26, 30, 34, 40, 46 45, 47, 49, 51, 53, 55

50, 54, 58, 62, 66 57, 61, 69, 71, 73

70, 74, 82, 86, 94 75, 77, 81, 83, 93

98, 104, 110 95, 99, 101, 105

107


50' MIN. CLEARANCE
 10' MIN. CLEARANCE
 10' MIN. CLEARANCE
 10' MIN. CLEARANCE

DATE _____

TOWN OF LEXINGTON — BOARD OF PUBLIC WORKS

WATER DIVISION

Sketch of Service Here

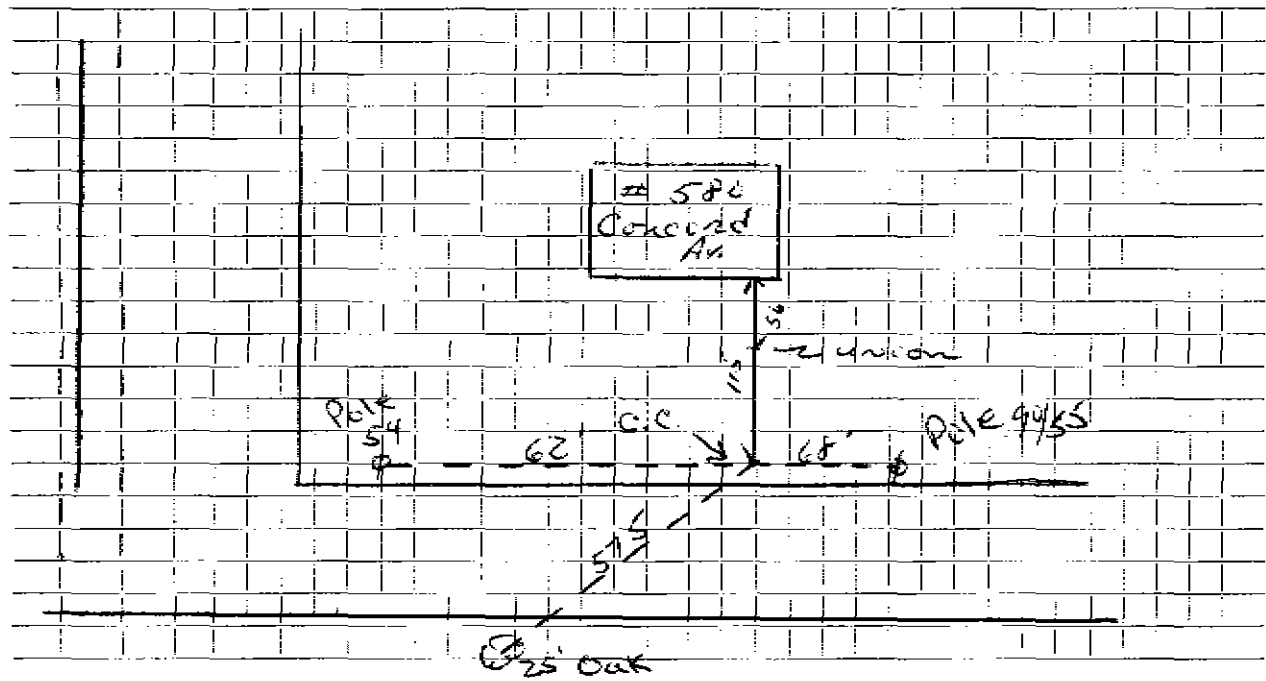

Connection made in Street. Work completed

Remarks:
.....
.....