


DATE _____

TOWN OF LEXINGTON — BOARD OF PUBLIC WORKS

WATER DIVISION

Sketch of Service Here

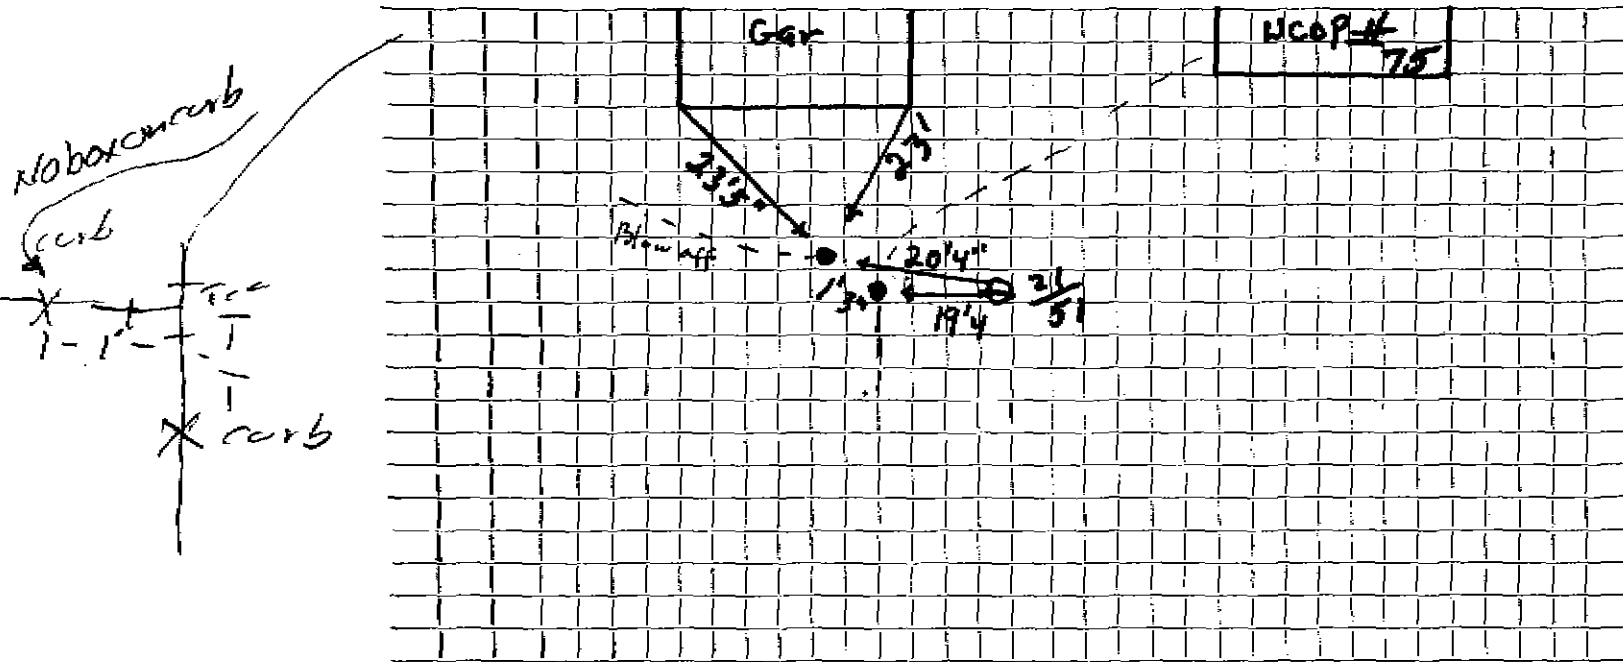

Connection made in Concord Ave 2 Curb's Street. Work completed


Remarks: 1 Curb for Garage 1 Curb for Main Blvd
Blow off

TOWN OF LEXINGTON — BOARD OF PUBLIC WORKS

WATER DIVISION

Sketch of Service Here

Tee
with curb
not Cox

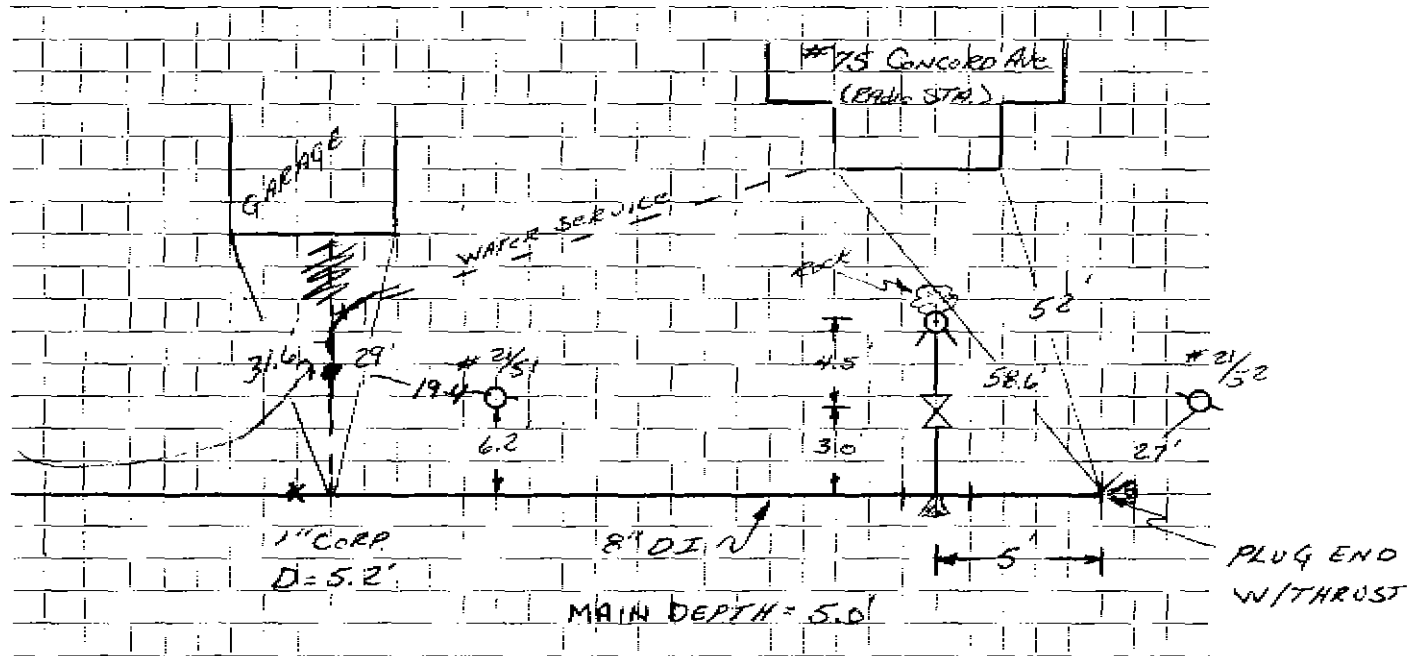

Connection made in ... CONCORD AVE Street. Work completed ... 11/30/81

Remarks: ... WATER SERVICE TO #75 HAS A TEE FROM SERVICE TO GARAGE

..... CONTRACT 82-3-E