

Name *Social Service Center* WATER SERVICE RECORD
 H. T. Powell Corp. (Met. State Bldg.)

Service No.

Address 76 Concord Avenue

Location

~~Repair~~ ~~Renewal~~ — New Service *Richard Baptiste*


Date	Material	Amount	Total	Date	Amount
12/17/83 & 2/9/84	103' 4" D.I. Pipe				
	30' 6" D.I. Pipe				
	8" x 6" Tap Sleeve & Gate				
	6" x 4" Reducer				
	4" Gate				
	Post Indicator				
	4" Tee				
	4" Plug Tap 1½"				
	1½" Elbow				
	1½" Curb				
	Gate Box				
	Roadway Box				
	3' 1½" Copper				
	Patch - 7' x 22'				
	9' x 12'				

DATE _____

TOWN OF LEXINGTON — BOARD OF PUBLIC WORKS

WATER DIVISION

Sketch of Service Here

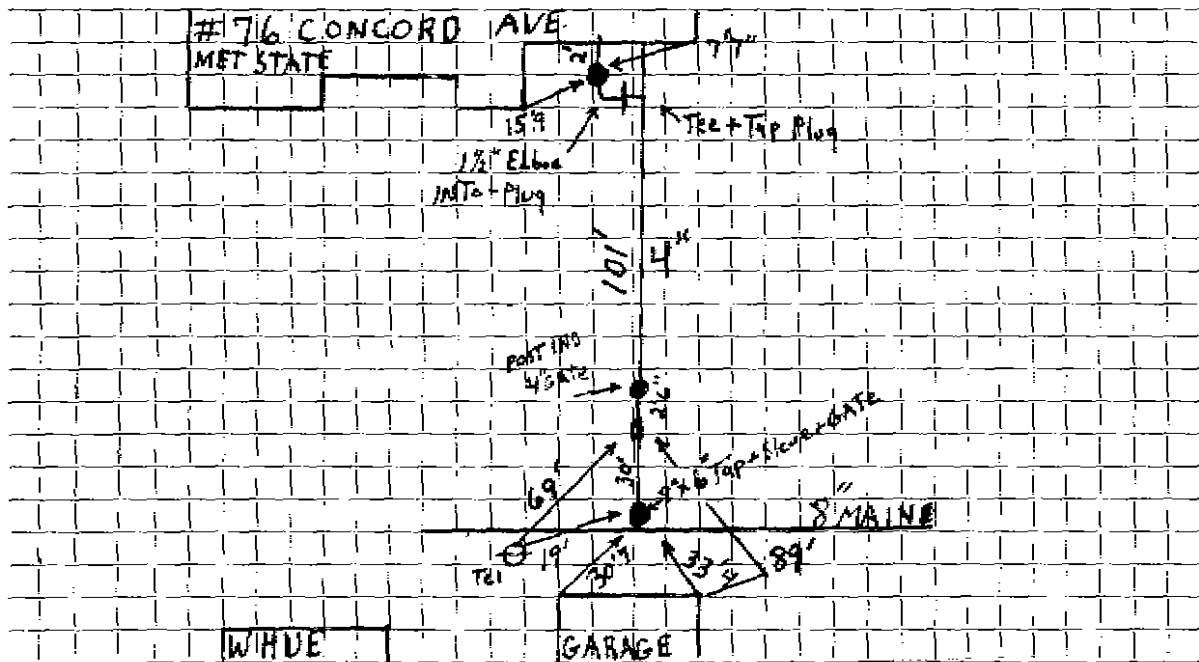

Connection made in 8" x 6" T&G - Reduced To 4" Street. Work completed

Remarks: Tee 1' out from Curb

Solid Sleeve 25' out from Post Indicator