
WATER SERVICE RECORD Name Service No.									
Address	PO CONCORD	Ave &	PROP. CON	N. TO POTTERS PON	'D				
Location	Address 90 CONCORD AVE & PROP. CONN. TO POTTERS FOND Location NOW 114 Potters Found								
Repair—Renewal—New Service									
Date	Material	Amount	Total	Date	Amou				
									
		<u></u> -							
		-	·						
			:						
		<u> </u>	·						
:									
	······································								
				 					
·· <u> </u>				 					
·				 					
		:							
	·			<u> </u>					
	· · · · · · · · · · · · · · · · · · ·								
		İ	:		į				

DATE		

TOWN OF LEXINGTON - BOARD OF PUBLIC WORKS

WATER DIVISION

Sketch of Service Here

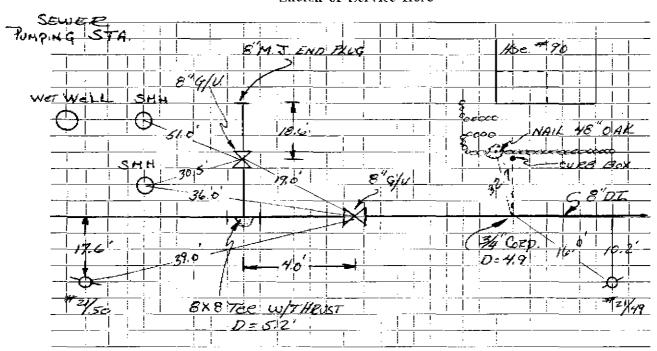

Connection made in . CONCORD AVE Street.	Work completed 12/3/8112/4/81
Romarks: CANTRAIT 82-7-E	•