

WATER SERVICE RECORD

Name

Service No.

Address

94 CONCORD AVE

Location


Repair—Renewal—New Service

Date	Material	Amount	Total	Date	Material	Amount
11/9/61	84' 3/4 COPPER			11/9/61	30' 3/4 COPPER	
	1 3/4x1/2 STOP+WASTE				3/4 CORP	
	1 3/4 - 3PART UNION				3/4 CURB	
					BOX+ROD	
					NEW MAIN	
				1982	3/4 CORP	

DATE _____

TOWN OF LEXINGTON — BOARD OF PUBLIC WORKS
WATER DIVISION

Sketch of Service Here

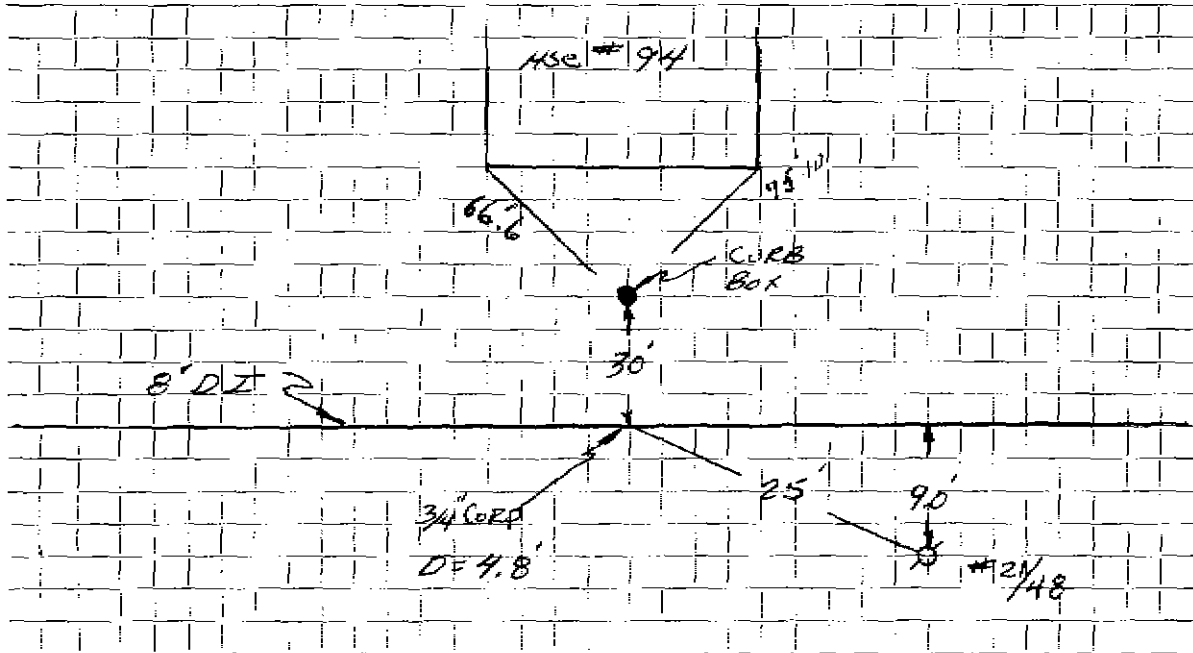

Connection made in CONCORD AVE. Street. Work completed 12-4-81

Remarks: CONTRACT 82-3-E
6-17-03 Contractor Geoffe service - repair made
at garage 2-3/4 pt. unions. - 4' Copper