


TOWN OF LEXINGTON — BOARD OF PUBLIC WORKS

WATER DIVISION

Sketch of Service Here

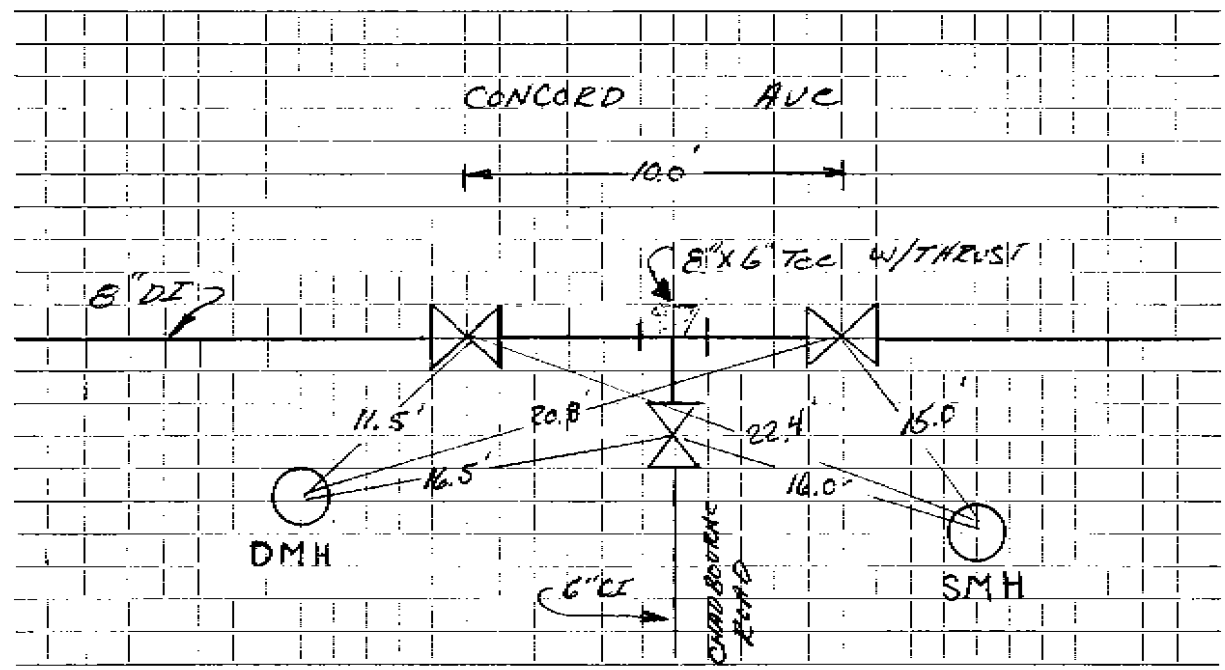

Connection made in Street. Work completed

Remarks: INTERSECTION OF CONCORD AVE & CHADBOURNE ROAD
GATE TIES