


DATE _____

TOWN OF LEXINGTON — BOARD OF PUBLIC WORKS
WATER DIVISION

Sketch of Service Here

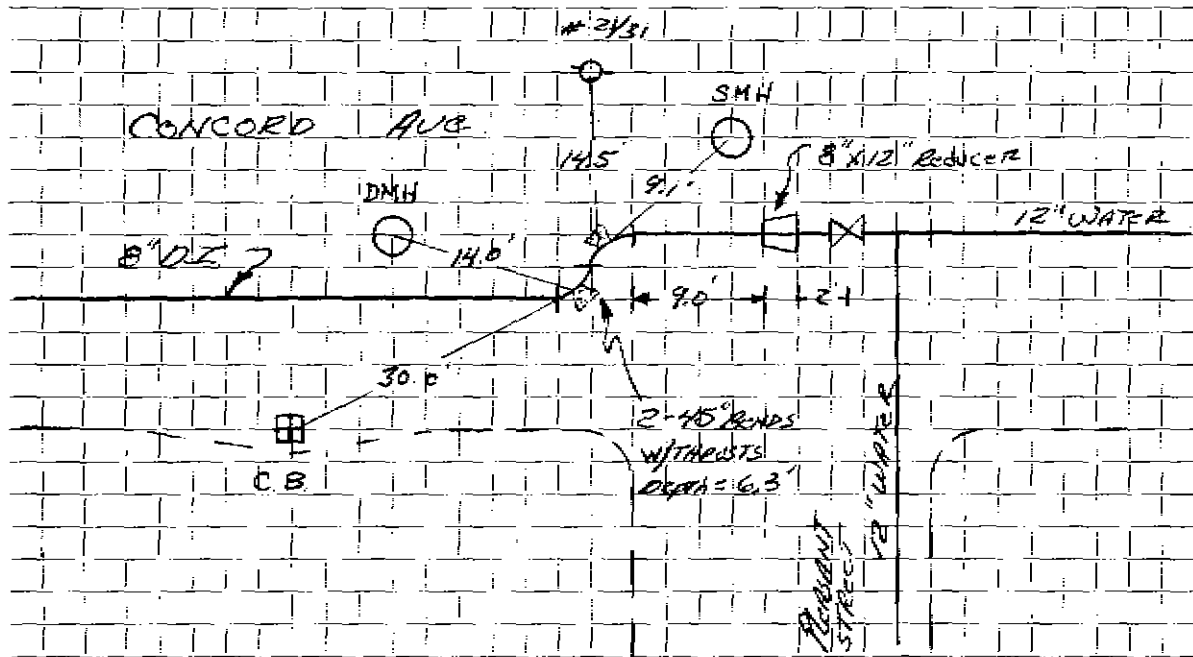

Connection made in CONCORD AVE Street. Work completed 3/18/82

Remarks: DEPTH @ GATE = 4.7' ; 12\"/>