


DATE _____

TOWN OF LEXINGTON — BOARD OF PUBLIC WORKS
WATER DIVISION

Sketch of Service Here

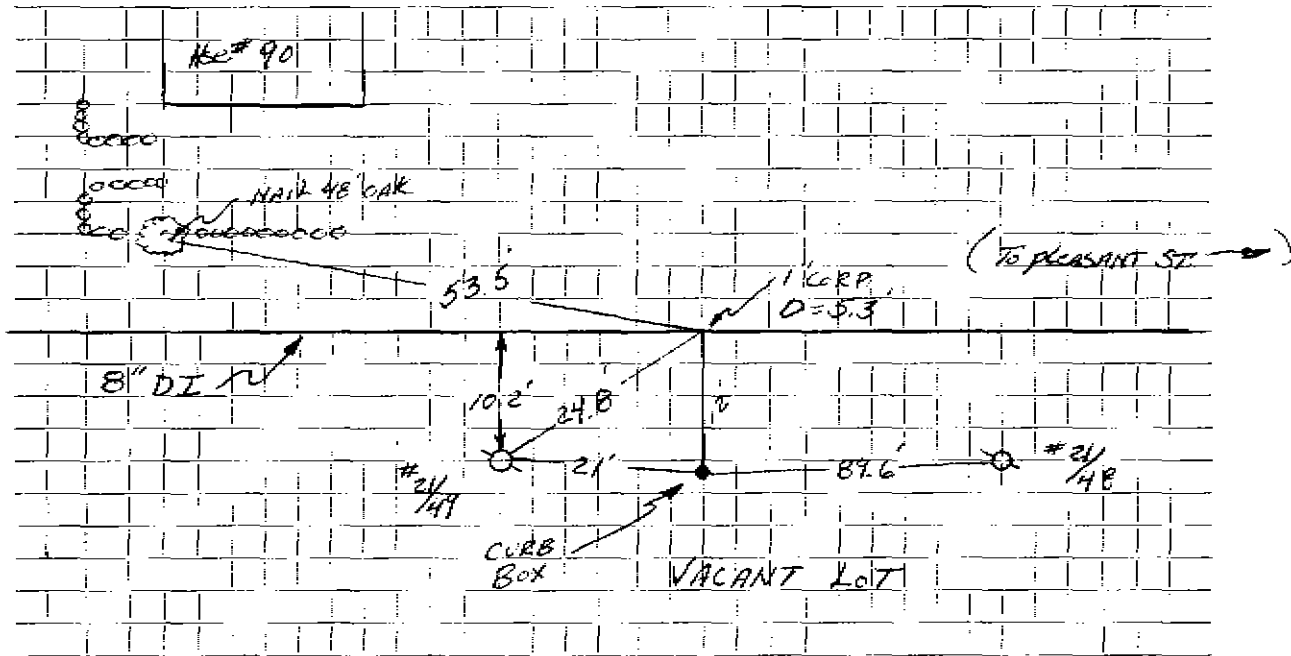


Connection made in CONCORD AVE Street. Work completed 12/4/81

Remarks: CONTRACT BZ-3-E

DATE _____

TOWN OF LEXINGTON — BOARD OF PUBLIC WORKS
WATER DIVISION

Sketch of Service Here

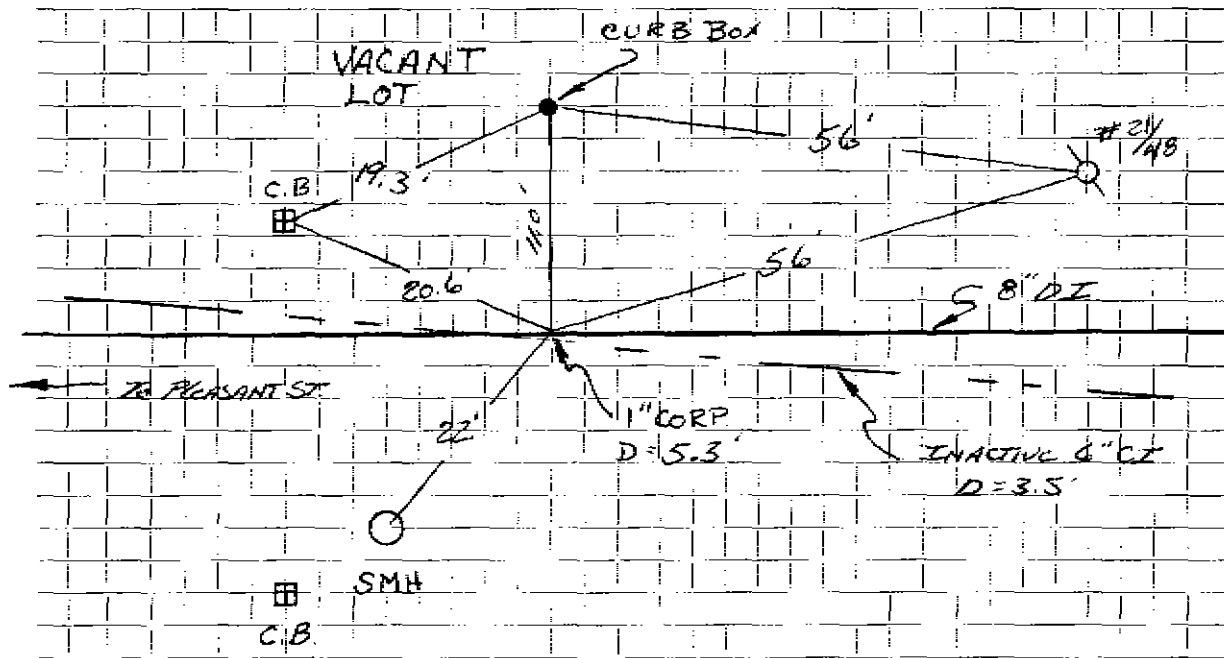

Connection made in CONCORD AVE. Street. Work completed

Remarks: CONTRACT 82-3-E