


DATE _____

TOWN OF LEXINGTON — BOARD OF PUBLIC WORKS WATER DIVISION

Sketch of Service Here

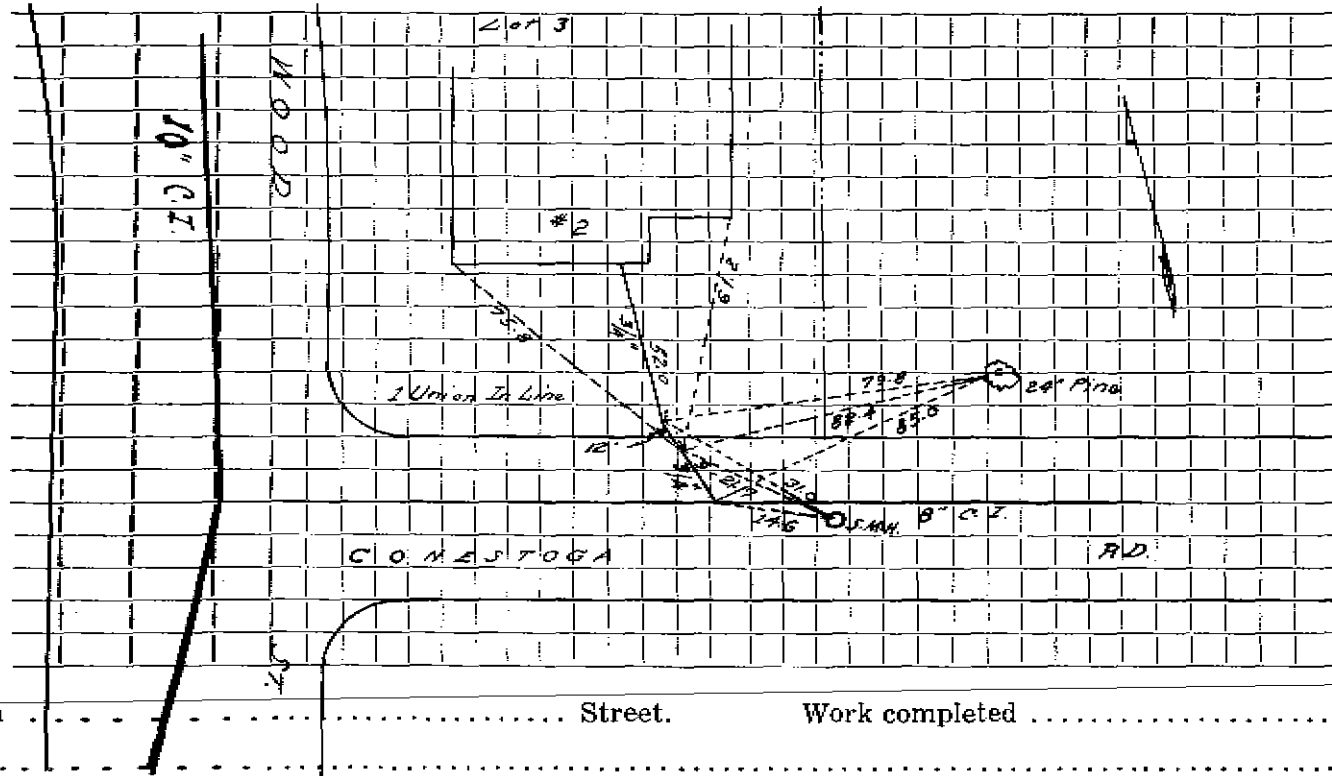

Connection made in _____ Street. Work completed

Remarks:

.....

.....