

WATER SERVICE RECORD

1152

Name Leeland Const. Co.

Service No. 107

Address 1 Constitution Road

Location


~~Branch~~ New Service W.O.#8218

Cam 2-10-64

Date	Material	Amount	Total	Date	Amount
10/11/63	Labor	2 31			
	10% O.H.	23	2 54	11-1-63	Deposit
	60' 3/4" Copper Tubing @ .42		25 20	2-10-64	Retund
	1 3/4" Cx 1/2 I.W.H. Stop & Waste		6 17		
			33 91		
				10/11/63	Labor
					18' 3/4" Copper Tubing @ .42
					1 3/4" C Corp. Cock
					1 3/4" C Curb Cock
					1 Bow & Rod
					1 1/2 Straight Tailpiece
					1 1/2 Offset Tailpiece
					26 70

WATER DIVISION

Sketch of Service Here

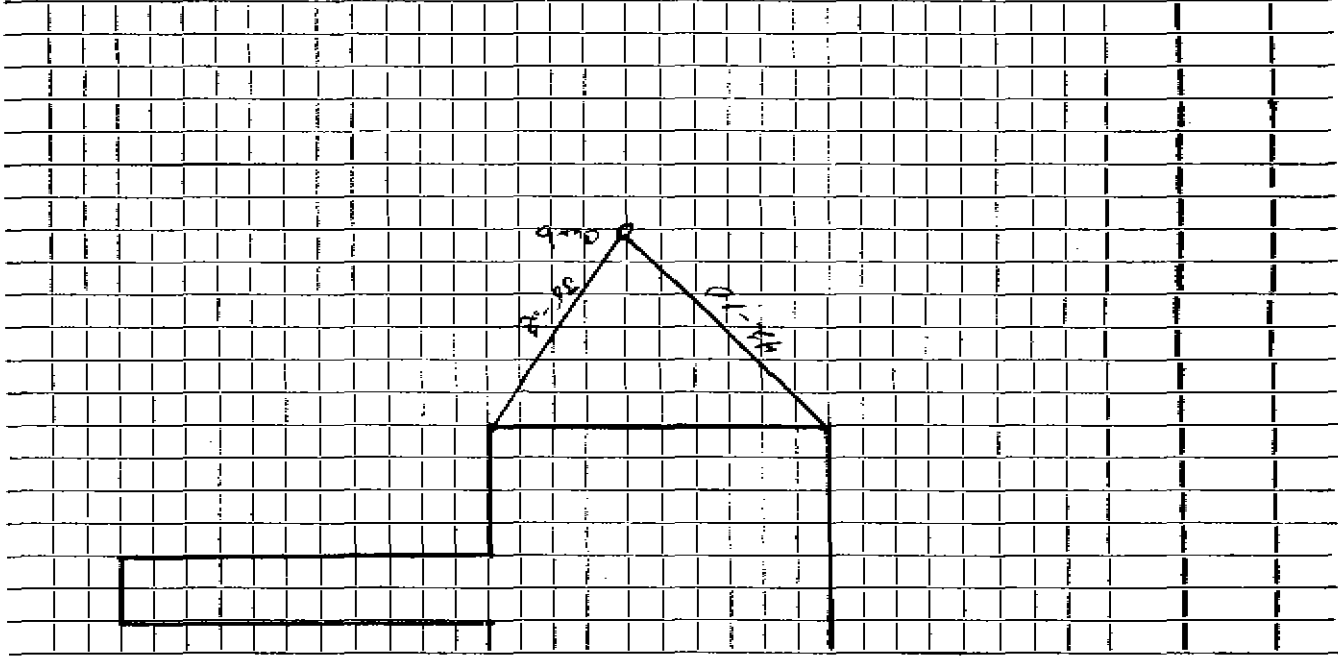

Connection made in _____ Street. Work completed _____

Remarks: _____