

WATER SERVICE RECORD

Name Leeland Construction Company

Service No. 20

Address 11 Constitution Road


Location \_\_\_\_\_

Repair—Renewal—New Service \_\_\_\_\_

Date	Material	Amount	Total	Date	Amount	
4/7/56	Labor	21 30		2-28-56	Deposit	\$ 100 00
	10% overhead	2 13	23 43	8-6-56	Refund	6 20
	50' 3/4" Copper tubing @ .4850		24 25		<u>NON CHARGES</u>	93 80
	1 3/4" C x 1/2" I.W.H. stop&waste		4 96		1 3/4" Straight tail piece	50
	4 2/3 hrs. Littlefield @ 8.50		39 66		1 3/4" Offset tail piece	50
	2 hrs. trucking @ .75		1 50			1 00
			93 80			
				9/27/55		
				10'	3/4 COPPER	
				1	3/4 Curb Cock	
				1	3/4 CORP COCK	
					Box & Rod	

TOWN OF LEXINGTON — BOARD OF PUBLIC WORKS  
WATER DIVISION

Sketch of Service Here

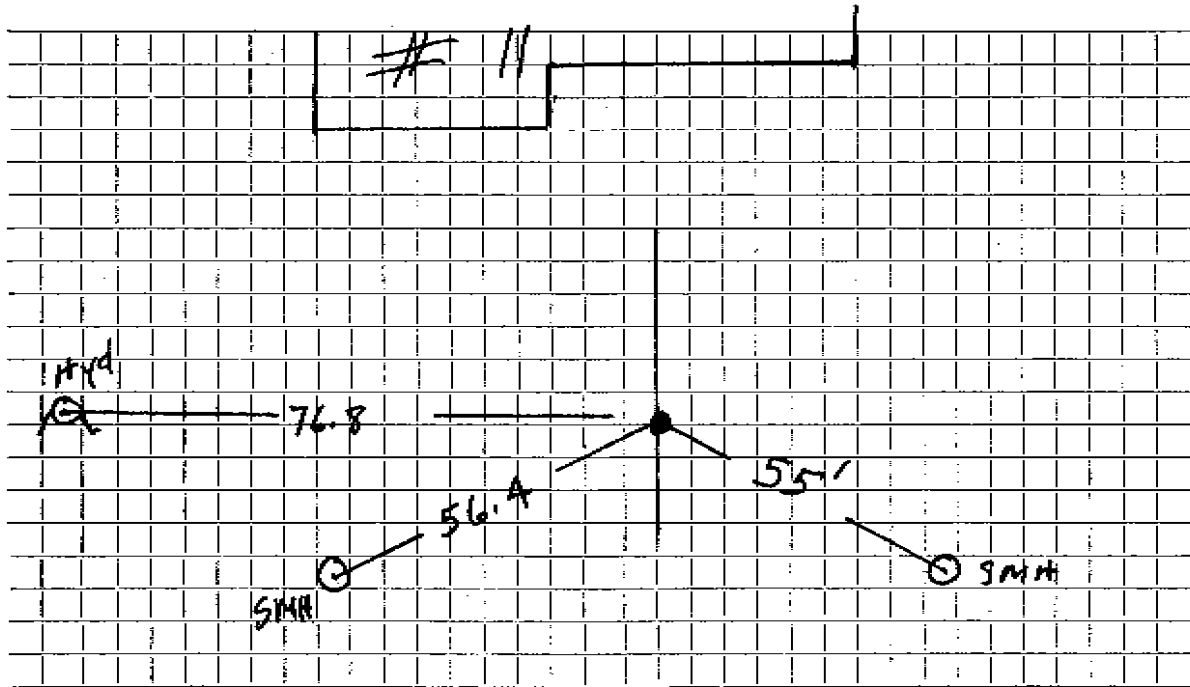

Connection made in ..... Street. Work completed .....

Remarks: .....  
.....  
.....