

WATER SERVICE RECORD

Service No.

Name

Address

15 Constitution Road

Location

~~Repair or Renewal~~ - New Service

Service into curb only

Date	Material	Amount	Total	Date	Amount
10-26-56	60' 3/4" Copper 1 3/4" C. X 1/2" I.W.H. Stop Waste				
					Non Charge
				9/27-28/55	Labor 1 60
					10'-3/4" Copper tubing @.55 5 60
					1-3/4" C Corp Cock 4 33
					1-3/4" C Curb Cock 4 67
					1 Box & Rod 3 90
					2 hr. trucking @.75 75
					<u>20 85</u>


DATE _____

TOWN OF LEXINGTON — BOARD OF PUBLIC WORKS

WATER DIVISION

Sketch of Service Here

W.S. FOR #15
6' OFF SPOT PAVE.

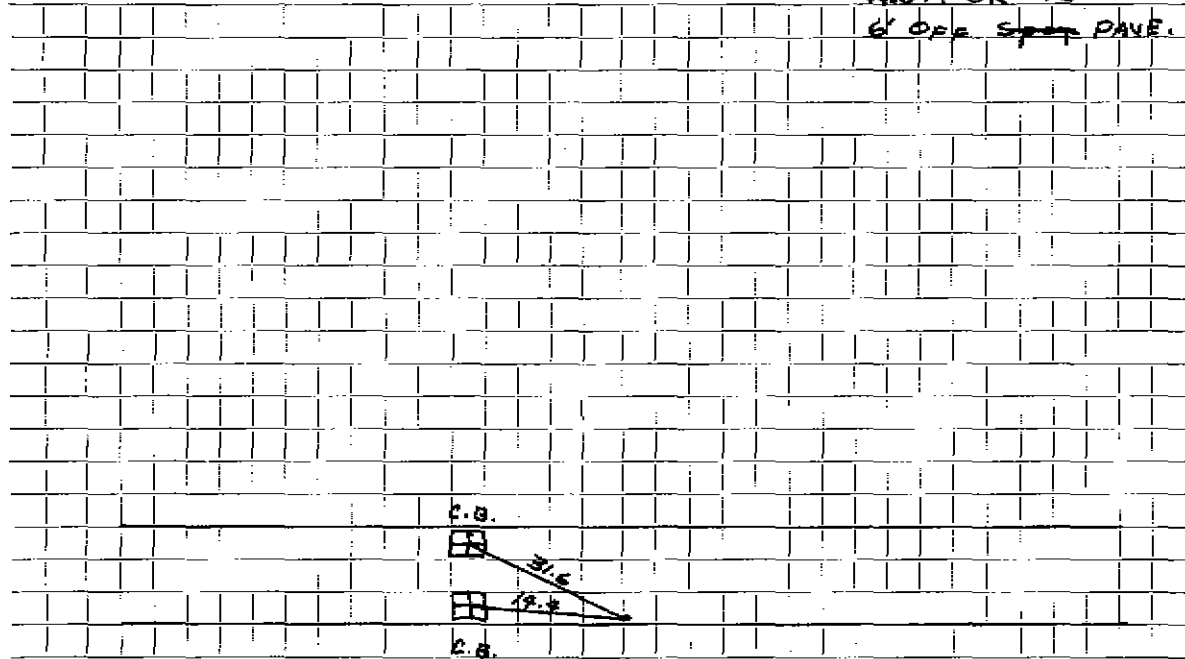

Connection made in Street. Work completed

Remarks:

.....

.....