




DATE \_\_\_\_\_

TOWN OF LEXINGTON — BOARD OF PUBLIC WORKS

**WATER DIVISION**

Sketch of Service Here

WS FOR # 18  
6' OFF PAVE.

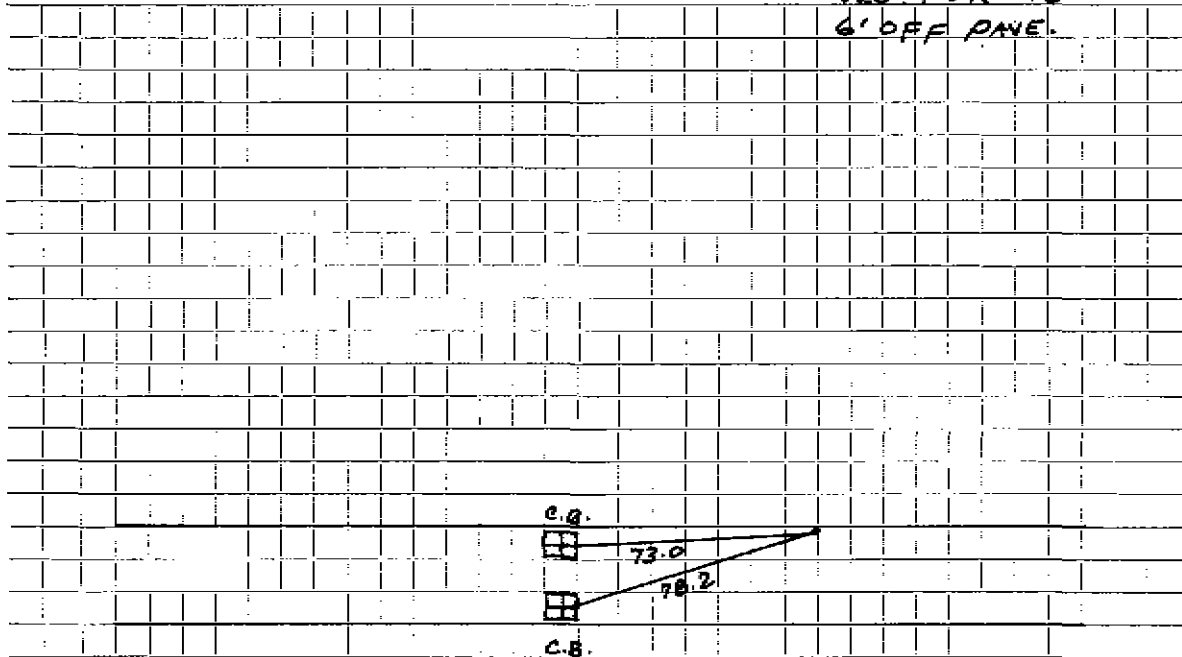

Connection made in ..... Street. Work completed .....

Remarks: .....  
.....  
.....