

Name Ross Realty Corp.

Service No. ~~100~~ 652

Address 173 Bedford St., Lexington, Mass.

#4015

2 Constitution Road Location

2 Constitution Road

Kind of Pipe

Size

Size of Main

Repair—Renewal—New Service

Location

Date
1941

Material

Amount

Total

Date

Amount

Nov. 8

4 hrs. @ 60¢

2 40

10% overhead

24

2 64

30' 3/4" Copper tubing @ 19¢

5 70

1 3/4" C.x¹/₂" I.S. & W.

2 50

1 hr. trucking

75

11 59

October 22, 1941 Deposited

14.00

Dec 30, 1941 Refund

2.41

11.59

Labor

TOWN OF LEXINGTON—BOARD OF PUBLIC WORKS

WATER DIVISION

The undersigned applies for a supply of water at No. _____ St. and hereby agrees to comply with the rules and regulations as now, or at any future time, established by the Board of Selectmen.

Am't. of Estimate \$ _____


Owner _____

Am't. Paid \$ _____

Address _____

Builder _____

Sketch of Service Here

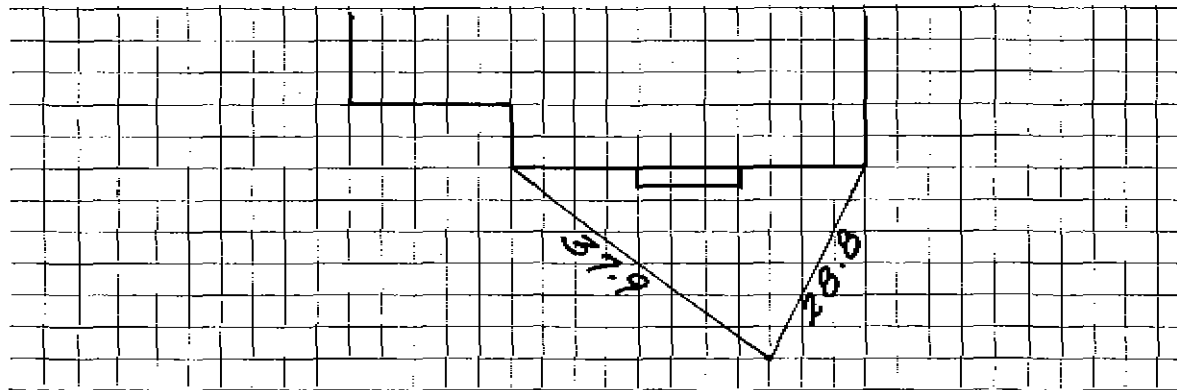

Connection made in _____ Street.

Work completed _____ 19


Remarks:

DATE _____

TOWN OF LEXINGTON — BOARD OF PUBLIC WORKS

WATER DIVISION

Sketch of Service Here

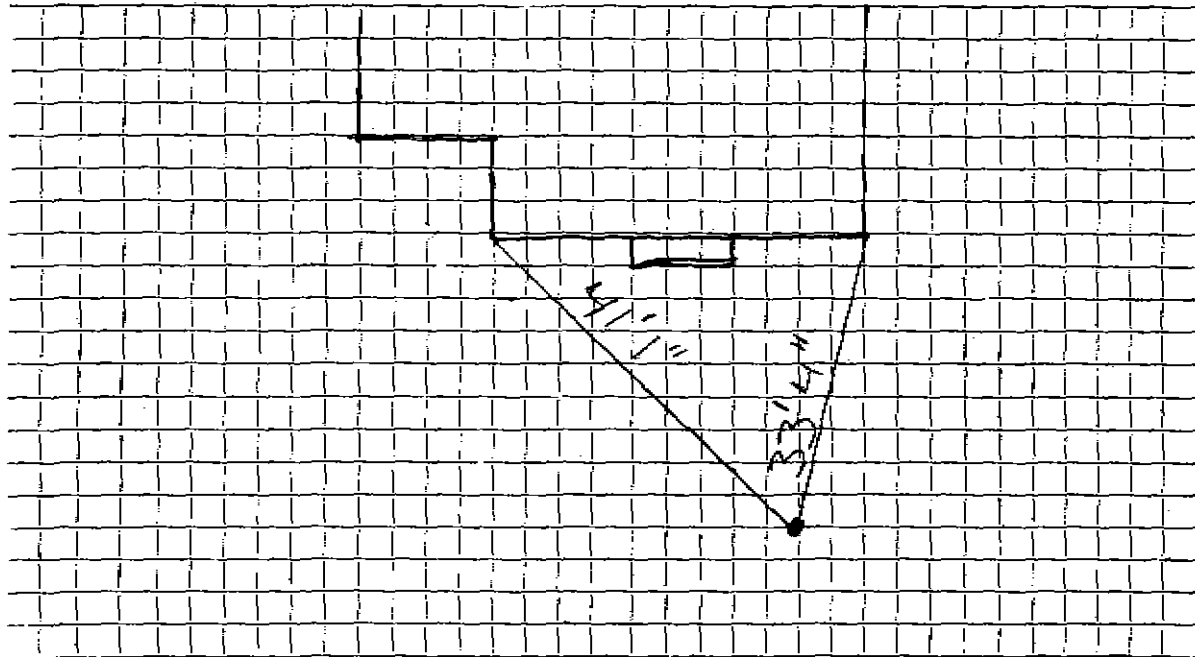

Connection made in Street. Work completed

Remarks:

.....

.....