

WATER SERVICE RECORD

1676

Name Leeland Construction

Service No. 212

Address 20 Constitution Road

Location

~~Remarks~~ - New Service

Comm 11-14-60


Date	Material	Amount	Total	Date	Amount	
8-3-59	Labor	1 85		10-4-60	Deposit	50 00
	10% O. H.	19	2 04	11-14-60	Paid by 5/11/4/197	6 65
	23' 3/4" Copper tubing @.38		8 74			56 65
	1 Hr. Trucking @.75		75		<u>NON CHARGE</u>	
	1 C 3 part Union		2 30	8-3-59	Labor	1 85
			13 83	28'	3/4" Copper tubing @.38	10 64
	BILL WHEN CONNECTED				1 3/4" C Corp Cock	4 67
10-6-60	Labor	3. 74			1 3/4" C Curb Cock	6 07
	10% O.H.	37	4. 11		1 Box & Rod	5 00
	66" 3/4" Copper tubing @ .42		27. 72			28 23
	1 3/4" C x 1/2 I.W.H. Stop & Waste	6. 17			1 1/2 Straight Tailpiece	.50
	2 3/4" C 3 part Unions @2.41	4. 82			1 1/2 Offset tailpiece	.50
			56. 65			29. 23

DATE _____

TOWN OF LEXINGTON — BOARD OF PUBLIC WORKS

WATER DIVISION

Sketch of Service Here

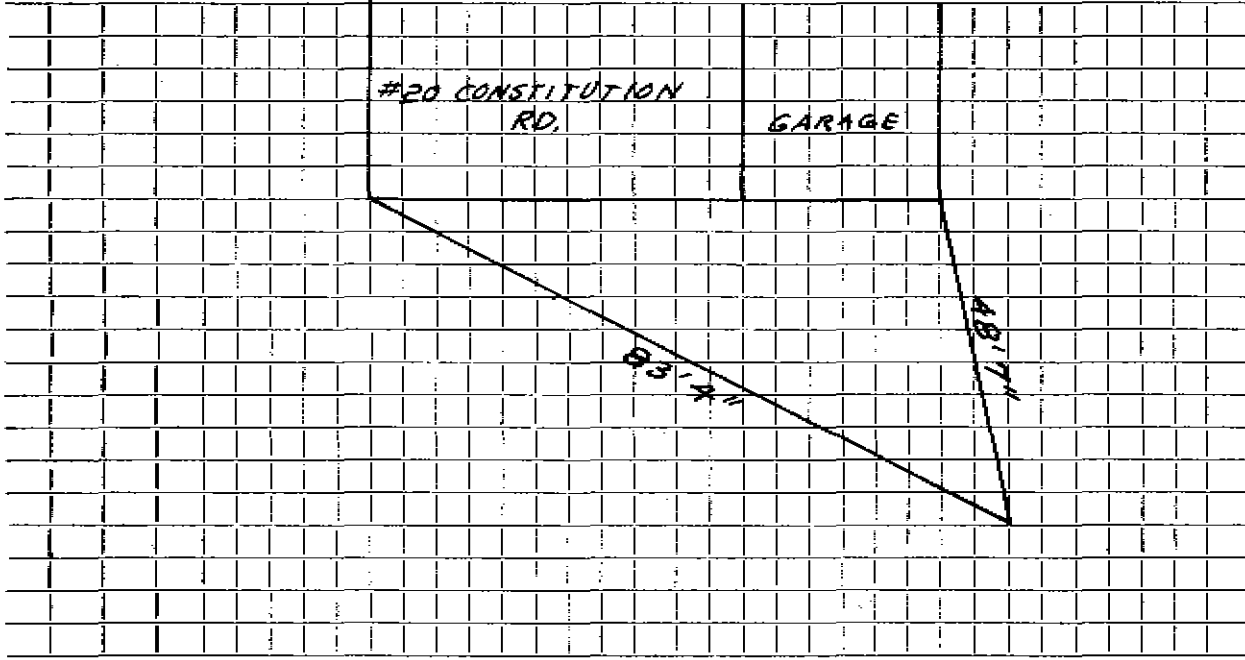

Connection made in Street. Work completed

Remarks:
.....
.....