




DATE \_\_\_\_\_

**TOWN OF LEXINGTON — BOARD OF PUBLIC WORKS**  
**WATER DIVISION**

Sketch of Service Here

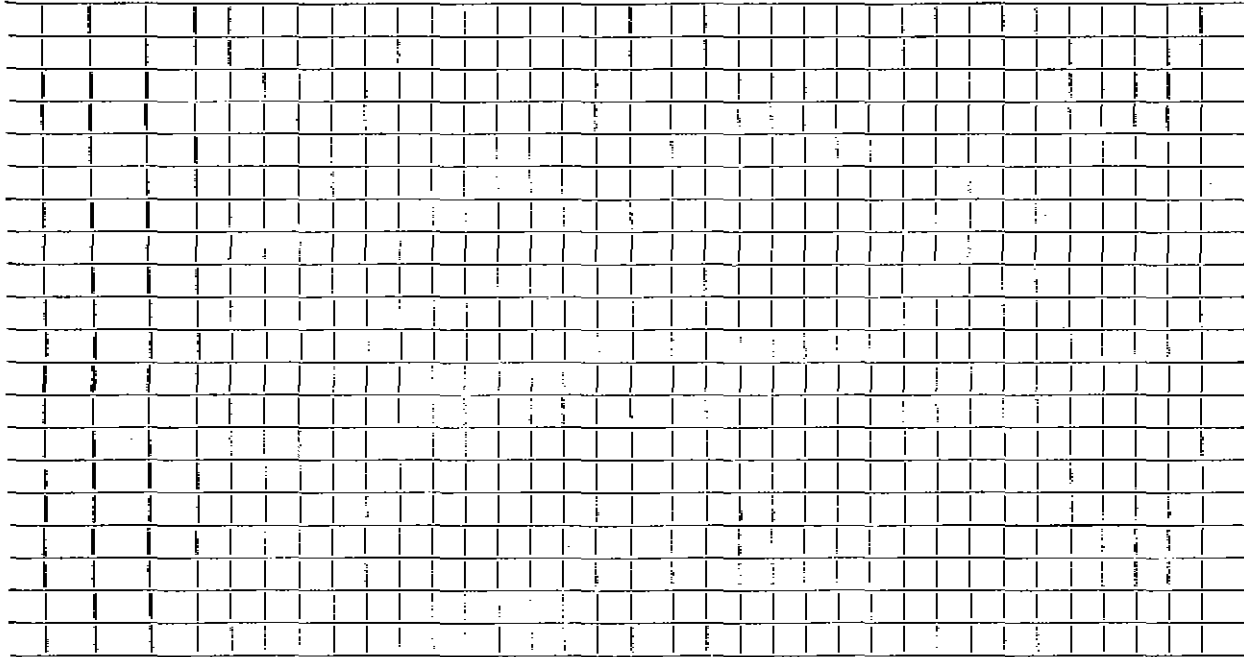

Connection made in ..... Street.                      Work completed .....

Remarks: .....  
.....  
.....