

WATER SERVICE RECORD

#5229

Name Leeland Construction

Service No. 183

Address 24 Constitution Road

Location

~~Repaired~~ ~~Replaced~~ - New Service

Comp 11-14-60


Date	Material	Amount	Total	Date	Material	Amount
8-4-59	Labor	1 85		10-4-60	Deposit	35 00
	10% O. H.	19	2 04	11-14-60	Paid by S/H #197	9 76
18'	3/4" Copper tubing @.38		6 84			44 76
1	Hr. Trucking @.75		75		<u>NON CHARGE</u>	
			9 63	8-4-59	Labor	1 85
	BILL WHEN CONNECTED			25'	3/4" Copper tubing @.38	9 50
10-7-60	Labor	3.90		1	3/4" C Corp Cock	4 67
	10% O.H.	39	4.29	1	3/4" C Curb Cock	6 07
53'	3/4" Copper tubing @.42		22.26	1	Box & Rod	5 00
1	3/4" C x 1/2 I.W.H. Stop & Waste		6.17			27 09
1	3/4" C 3 part Union		2.14	1	1/8 Straight tailpiece	.50
			44.76	1	1/8 Offset tailpiece	.50
						28 09

DATE _____

TOWN OF LEXINGTON — BOARD OF PUBLIC WORKS

WATER DIVISION

Sketch of Service Here

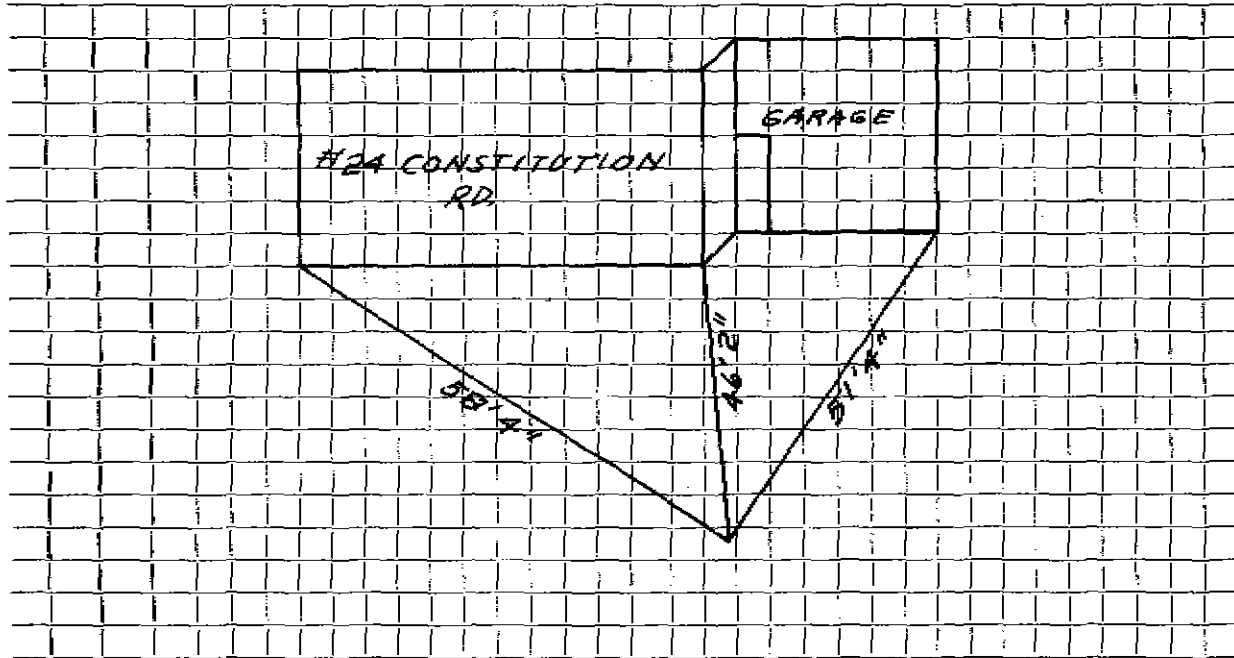

Connection made in Street. Work completed

Remarks:

.....
.....