

WATER SERVICE RECORD

Name Leeland Const. Co.

Service No. 113

Address 25 Constitution Road

Location

~~Repair~~ ~~Renewal~~ New Service

Comm 8-22-60


Date	Material	Amount	Total	Date	Amount
7-12-60	Labor	1 94		7-7-60	Deposit 50 00
	10% O.H.	19	2 13	8-22-60	Refund 13 67
61'	3/4" Copper tubing @.42		25 62		36 33
1	3/4" Cx 1/2 I.W.H. Stop&Waste		6 17		<u>NON CHARGE</u>
1	3/4" C3 part Union		2 41	7-31-59	Labor 1 85
			36 33	22'	3/4" Copper tubing @.38 8 36
				1	3/4" C Corp Cock 4 67
				1	3/4" C Curb Cock 6 07
				1	Box & Rod 5 00
				1	Hr. Trucking @.75 75
					26 70
				1	1/8 Straight tailpiece 50
				1	1/8 Offset tailpiece 50
					27 70
				9-27-65	PA 65-DETERGENTS

DATE \_\_\_\_\_

TOWN OF LEXINGTON — BOARD OF PUBLIC WORKS

WATER DIVISION

Sketch of Service Here

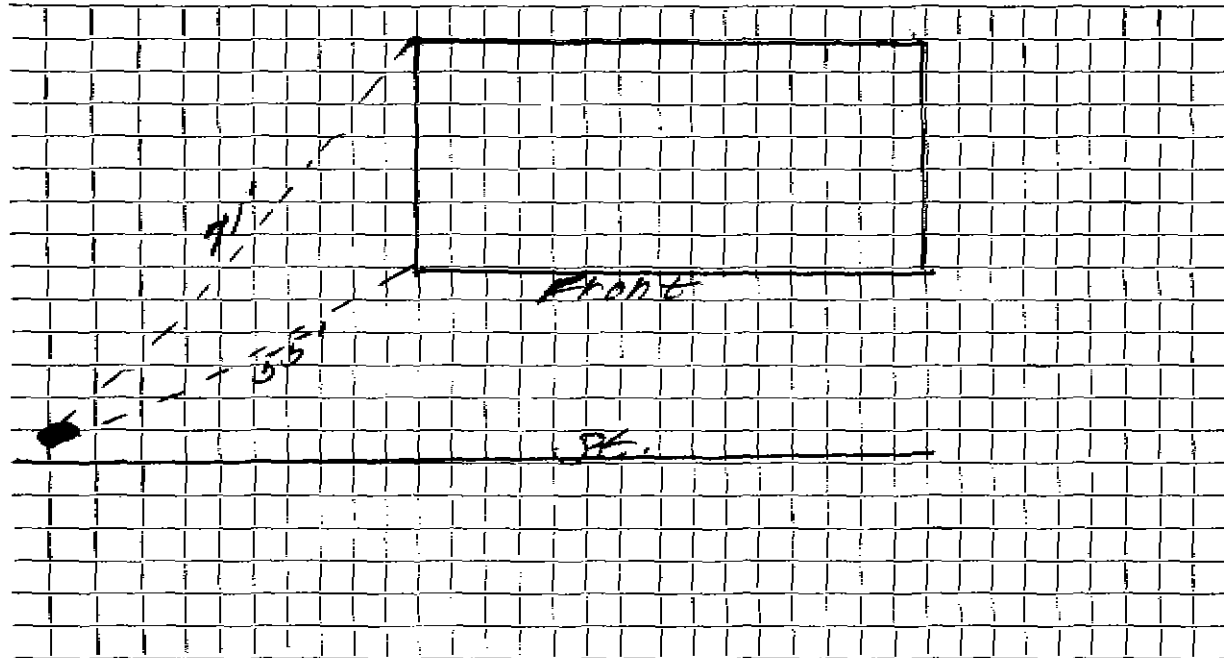

Connection made in ..... Street. Work completed .....

Remarks: .....

.....  
.....