

WATER SERVICE RECORD

Name Leeland Construction

Service No. 184

Address 26 Constitution Road

# 2795

Location

~~Repair/Extension~~ - New Service

Conn 11-1960


Date	Material	Amount	Total	Date	Amount	
8-5-59	Labor	1 85		8-23-60	Deposit	35 00
	10% O. H.	19	2 04	11-14-60	Paid by SH # 500	13 54
18'	3/4" Copper tubing @.38		6 34			48 54
1	Hr. Trucking @.75		75		<u>NON CHARGE</u>	
			9 13	8-5-59	Labor	1 85
	BILL WHEN CONNECTED					
				25'	3/4" Copper tubing @.38	9 50
10-6-60	Labor	2.05		1	3/4" C Corp Cock	4 67
	10% O.H.	.21	2 26	1	3/4" C Curb Cock	6 07
63'	3/4" Copper tubing @.42		26 46	1	Box & Rod	5 00
1	3/4" C x 1/2 I.W.H. Stop & Waste		6 17			27 09
2	3/4" C 3 part unions @2.41		4 82	1	1/2 Straight tailpiece	50
			48 84	1	1/2 Offset tailpiece	50
						28.09

DATE \_\_\_\_\_

TOWN OF LEXINGTON — BOARD OF PUBLIC WORKS

WATER DIVISION

Sketch of Service Here

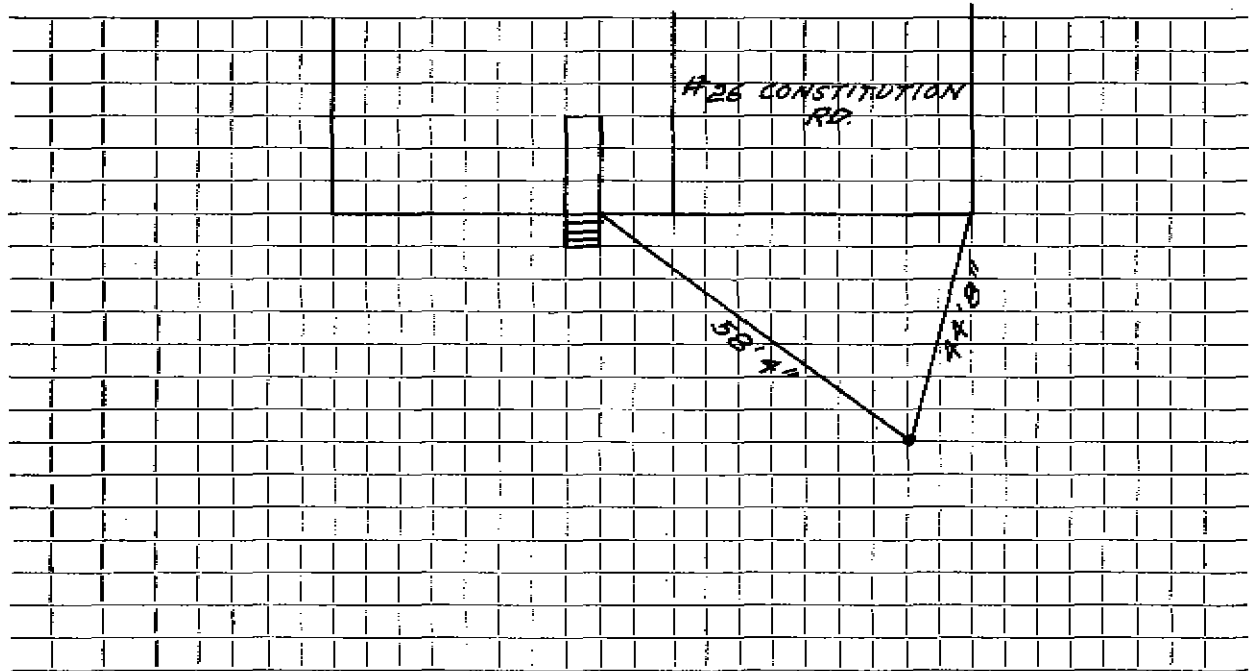

Connection made in ..... Street. Work completed .....

Remarks: .....  
.....  
.....