

5415

WATER SERVICE RECORD

Name Leeland Construction

Service No. 214

Address 27 Constitution Road

Location

~~Repair~~ ~~Renewal~~ New Service

Comm 11-21-60

Date	Material	Amount	Total	Date	Amount
10-10-60	Labor	3 99		10-4-60	Deposit
	10% O.H.	40	4 39	12-13-60	Paid
	155' 3/4" Copper tubing @.42		65 10		
	1 3/4" Cx 1/2 I.W.H. Stop&Waste		6 17		<u>NON CHARGE</u>
	2 3/4" C3 part Unions @.41		4 82	7-31-59	Labor
	1 Box & Rod		4 90		19' 3/4" Copper tubing @.38
			85 38		1 3/4" C Corp Cock
					1 3/4" C Curb Cock
					1 Box & Rod
					1 Hr. Trucking @.75
					25 56
				10-10-60	1 3/4" Straight tailpiece
					1 3/4" Offset tailpiece
					50
					26 56


Bill sent 11-21-60 357.38

DATE _____

TOWN OF LEXINGTON — BOARD OF PUBLIC WORKS

WATER DIVISION

Sketch of Service Here

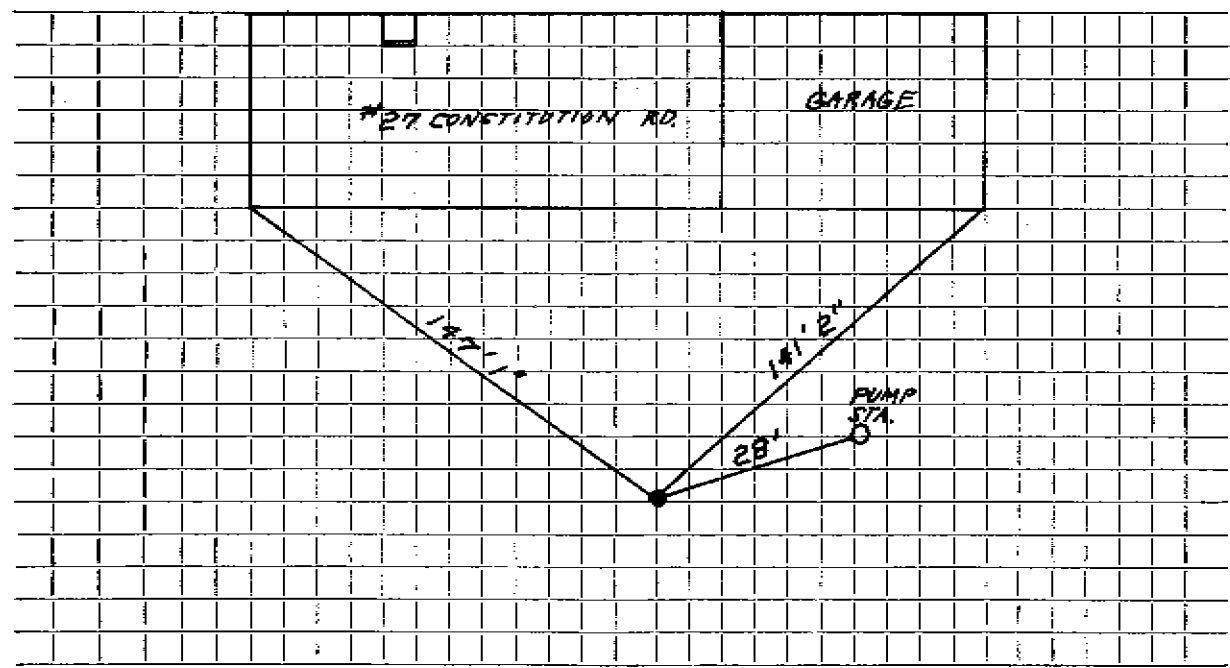

Connection made in Street. Work completed

Remarks:
.....
.....