

WATER SERVICE RECORD

Name Leeland Construction Co.

Service No. 289

Address 29 Constitution Road

Location Lot#55

~~Repair - Repair~~ New Service

Comm 12-31-57


Date	Material	Amount	Total	Date	Amount
11-6-59	Labor	1.85		11-3-59	50.00
	10% O.H.	.19	2.04	12-31-59	22.26
	40' 3/4" Copper tubing @.42		16.80		37.74
1	3/4" C x 1/2 I.W.H. Stop & Waste		5.88		<u>NON CHARGE</u>
1	3/4" C 3 part union		2.27	7-31-59	Labor 1.85
1	hr. Trucking @.75		.75	11-1	3/4" Copper tubing @.38 5.32
			27.74	1	3/4" C Corp Cock 4.67
				1	3/4" C Curb Cock 6.07
				1	Box & Rod 5.00
				1	Hr. Trucking 75
					<u>23.66</u>
				1	1/2 Straight tailpiece .50
				1	1/2 Offset tailpiece .50
					<u>24.66</u>

DATE _____

TOWN OF LEXINGTON — BOARD OF PUBLIC WORKS

WATER DIVISION

Sketch of Service Here

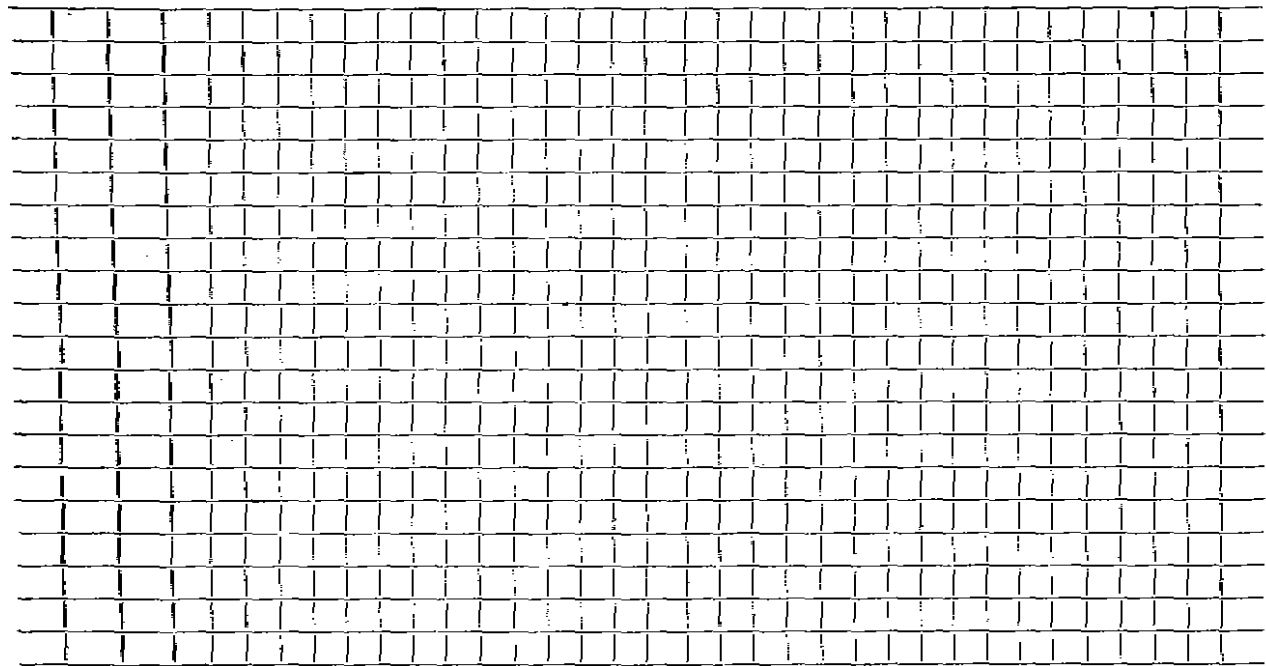

Connection made in Street. Work completed

Remarks:
.....
.....