

Name **Bo's Realty**

Service No. ~~# 4701~~ ~~# 653~~

Address **Lexington, Massachusetts
3 Constitution Rd.**

Location **3 Constitution Road**

Kind of Pipe

Size

Size of Main

Repair—Renewal—New Service

Location

Date 1941	Material	Amount	Total	Date	Amount
Nov. 22	2 hrs. @ 60¢	1 20		Nov. 14, 1941 Deposited	18.00
Com ¹⁷ / ₂₂ / 14	10% Overhead	12	1 32	Dec 30 1941 Refund	5.09
	47' 1" Copper tubing @ 22¢		10 34		
	1 1" C x 3/4" I.S. & W.		2 50		
	1 hr. trucking		75		
			14 91		14.91
	Labor				

Hadley Press, Inc., Lexington

DATE _____

TOWN OF LEXINGTON—BOARD OF PUBLIC WORKS

WATER DIVISION

The undersigned applies for a supply of water at No. _____ St. and hereby agrees to comply with the rules and regulations as now, or at any future time, established by the Board of Selectmen.

Am't. of Estimate \$ _____


Owner _____

Am't. Paid \$ _____

Address _____

Builder _____

Sketch of Service Here

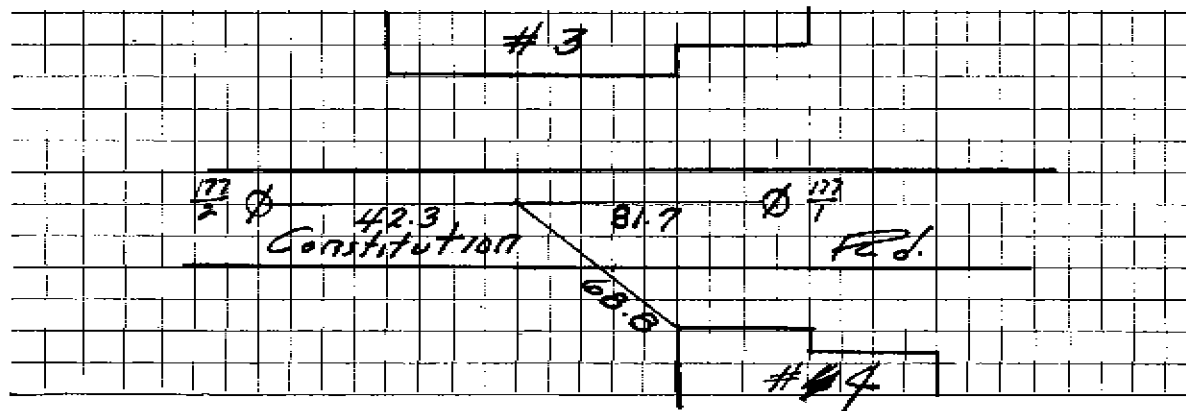

Connection made in _____ Street.

Work completed _____ 19

Remarks: