

WATER SERVICE RECORD

Name Leeland Construction

Service No. 185

Address 30 Constitution Road

Location

Repair—~~Reserve~~—New Service

Conn 11-14-60

Date	Material	Amount	Total	Date	Amount
7-31-59	Labor	1 85		8-23-60	35 00
	10% O. H.	19	2 04	11-14-60	4 24
	10' 3/4" Copper tubing @.38		3 80		39 00
	1 Hr. Trucking @.75		75		
			6 59	7-31-59	
	BILL WHEN CONNECTED				
				27'	3/4" Copper tubing @.38 10 26
10-5-60	Labor	3.88		1	3/4" C Corp Cock 4 67
	10% O.H.	.39	4.27	1	3/4" C Curb Cock 6 07
	40' 3/4" Copper tubing @.42		16.80	1	Box & Rod 5 00
	1 3/4" C x 1/8" I.M.H. Stop & Waste		6.17		27 85
	1 3/4" C 3 part union		2.41	1	1/2" Straight tailpiece 50
	1 hr. Trucking @3.00		3.00	1	3/8" Offset tailpiece 50
			39.24		28 85

Deposit
Paid by S.M. #1650


NON CHARGE

DATE _____

TOWN OF LEXINGTON — BOARD OF PUBLIC WORKS

WATER DIVISION

Sketch of Service Here

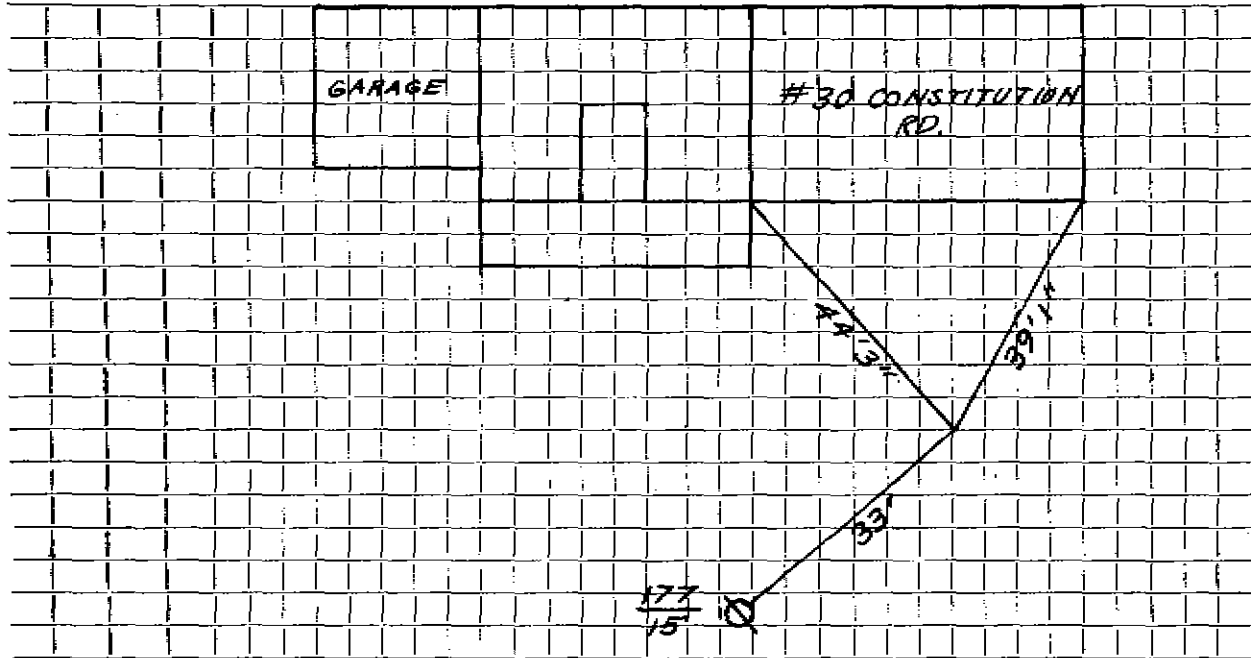

Connection made in Street. Work completed

Remarks:
.....
.....