

WATER SERVICE RECORD

Name _____ Service No. _____

Address 4 Constitution Road

Location _____


Repair—Renewal—New Service

Date	Material	Amount	Total	Date	Amount
12-22-41					
	30' 3/4" Copper				
	1 3/4" X 1/2" 1 Stop Waste				
	1 3/4" C X 3/4" 1 Union				
					NON CHARGE
				1958 Labor	3 73
				8' 3/4" Copper Tubing	2 96
				1 3/4" Style 88 Coupling	3 43
				1 Curb Box & Rod	5 00
				1 Style 38 Repair Clamp	2 14
				1 3/4" x 5" Cement Lined Nipple	75
				1 3/4" x 3/4 2 Part Union	1 24
				1 Hour Trucking @ .75	75
					<u>20 00</u>

TOWN OF LEXINGTON — BOARD OF PUBLIC WORKS

WATER DIVISION

Sketch of Service Here

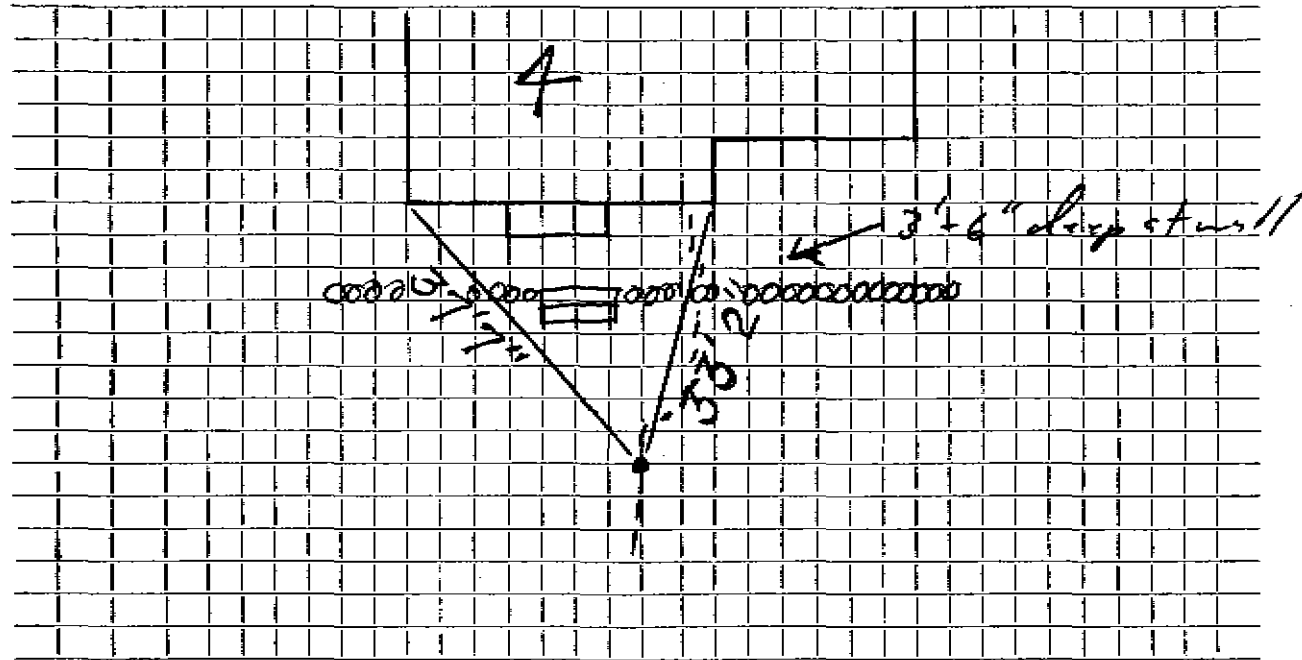

Connection made in Street. Work completed

Remarks: 3/4 x 9 inches 3' from curb.....

.....

.....