

Name James D. Wood
 Address 5 Constitution Road

Service No. 187
 #4375
 8425
 #6726

Location 5 Constitution Road

Kind of Pipe

Size

Size of Main

~~Repair~~ ~~Renewal~~ New Service

Com. 12/13/47

Location

Date	Material	Amount	Total	Date	Amount
12/18/47	Labor	2 10	2 10	12/14/47	40 00
	10% Overhead		21	12/31/47	9 91
	38' 3/4" Copper Tubing @.26		9 88		<hr/> 30 09
	1 3/4" Cx 1/2" I.W.H. Stop & Waste		3 15		Non-Charge
	2 hrs. Hired Shovel @ 7.00		14 00	12/18/47	Labor (Street Work) 4 90
	1 hr. Trucking		75		12' 3/4" Copper Tubing 3 12
			<hr/> 30 09		1 3/4" C.Corp.Cock 3 00
					1 3/4" Cx 3/4" C.CurbCock 3 68
					1 Box & Rod 4 26
					1 1/2" Straight Tailpiece 30
					1 1/2" Offset Tailpiece 30
					1 hr. Trucking 75
	Labor				<hr/> 20 31

DATE _____

TOWN OF LEXINGTON - BOARD OF PUBLIC WORKS

WATER DIVISION

The undersigned applies for a supply of water at No..... St. and hereby agrees to comply with the rules and regulations as now, or at any future time, established by the Board of Selectmen.

Am't of Estimate \$.....


Owner

Am't Paid \$.....

Address

Builder

Sketch of Service Here

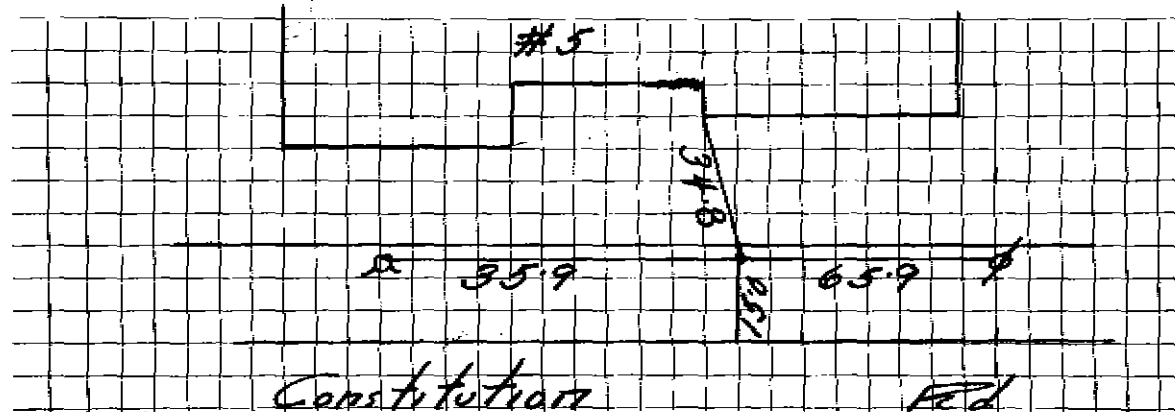

Connection made in Street.

Work completed19

Remarks: