

Name Howard G. Hunter

Service No. 85 3189

Address 7 Constitution Road

Lexington, Mass.

Location 7 Constitution Road

Kind of Pipe

Size

Size of Main

~~Repair~~ ~~Renewal~~ - New Service

Com. 12-16-46

Location

Date	Material	Amount	Total	Date	Amount
Sept. 19, '46	Labor	30 82	30 82	Sept 19, '46	40 00
	10% Overhead		3 08	Dec 20 '46	6 84
	25' - 3/4" Copper Tubing @ .23		8 05		46 84
	1 - 3/4" C x 3/4" I.W.H. S & W		2 82	Sept. 19, '46	15 52
	1 - 3/4" C x 3/4" Union (3 parts)		1 32	15' - 3/4" Copper Tubing @ .23	3 45
	Trucking 1 hr. @ .75		75	1 - 3/4" C Corp-cock	2 70
			46 84	1 - 3/4" C x 3/4" C Curb-cock	3 30
				1 - Box & Rod	3 50
				1 - 1/2" Straight Tail Piece	50
				1 - 1/2" Offset Tail Piece	50
				Trucking 1 hr. @ .75	75
	Labor				30 22

*Disputed*  
*and*  
Non-Charge

Hadley Press, Inc., Lexington

DATE \_\_\_\_\_

# TOWN OF LEXINGTON—BOARD OF PUBLIC WORKS

## WATER DIVISION

The undersigned applies for a supply of water at No. \_\_\_\_\_ St. and hereby agrees to comply with the rules and regulations as now, or at any future time, established by the Board of Selectmen.


Am't. of Estimate \$ \_\_\_\_\_

Owner \_\_\_\_\_

Am't. Paid \$ \_\_\_\_\_

Address \_\_\_\_\_

Builder \_\_\_\_\_

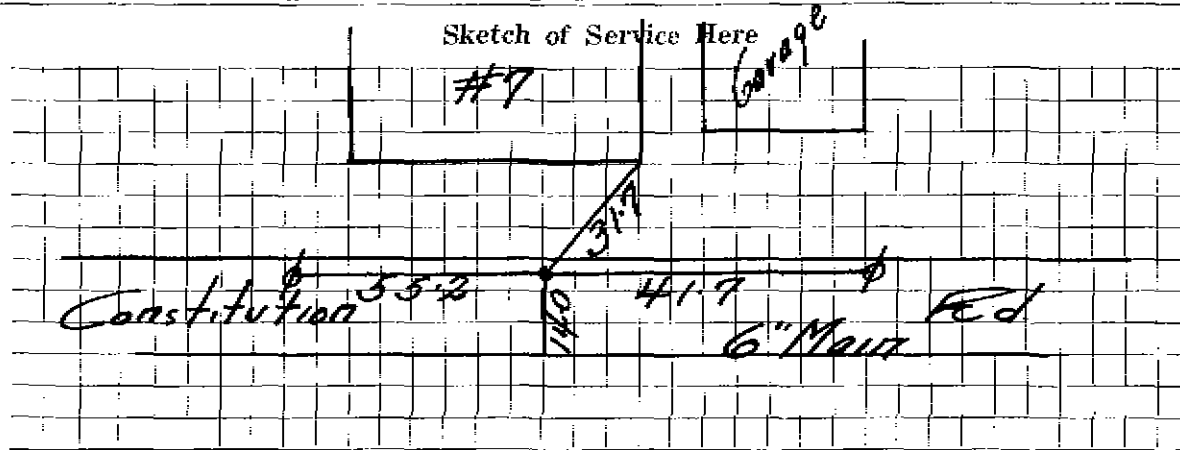

Connection made in \_\_\_\_\_ Street.

Work completed \_\_\_\_\_ 19

Remarks: