

WATER SERVICE RECORD

Name

Service No.

Address

8 Constitution Road

Location

LOT #1

~~Repair~~ ~~Renewal~~ New Service


Service into curb only

Date	Material	Amount	Total	Date	Amount
2-3-56	42' 3/4" Copper				
	1 3/4" C. X 1/2" I.W.H. STOP + Waste				
					Non Charge
				8/27-28/56	Labor 1 60
					25' - 3/4" Copper tubing @.56 14 00
					1-3/4" C Core Cock 4 83
					1-3/4" C Curb Cock 4 67
					1 Box 3: Rpd 3 90
					1 hr. trucking @.75 75
					29 25

DATE \_\_\_\_\_

TOWN OF LEXINGTON — BOARD OF PUBLIC WORKS  
**WATER DIVISION**

Sketch of Service Here

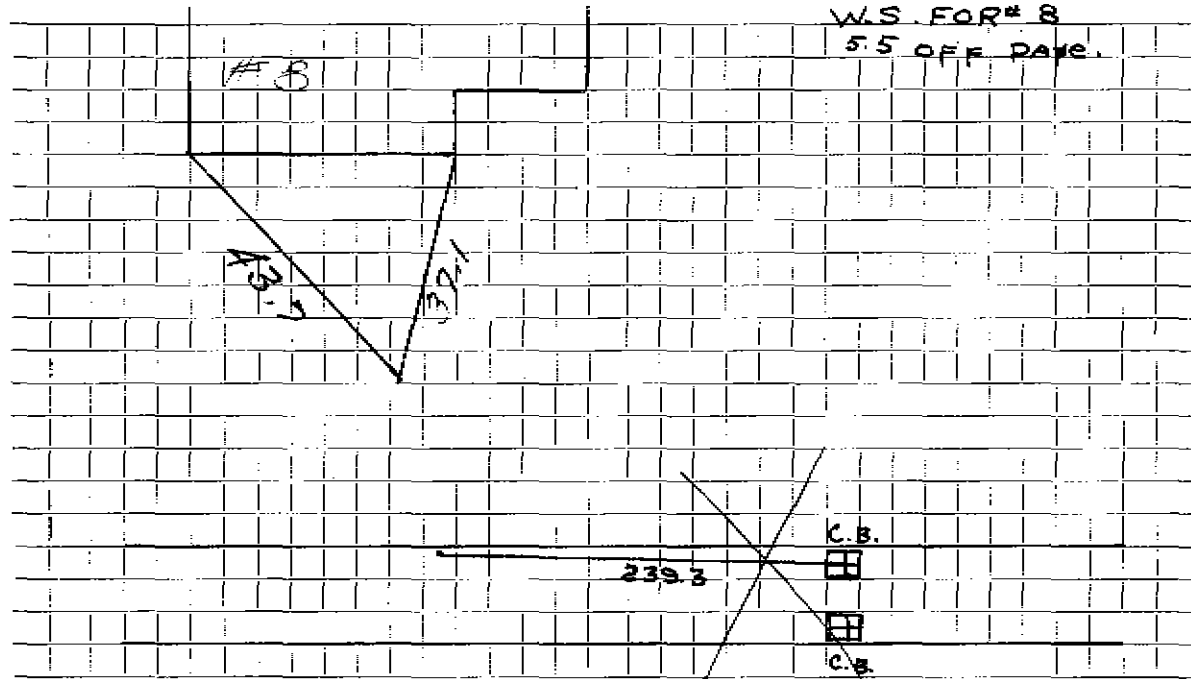

Connection made in ..... Street. Work completed .....

Remarks: .....  
.....  
.....