

WATER SERVICE RECORD

Name Albert Wills

Service No. 330

Address 37 Coolidge Ave.

# 2514

# 7735

Location Lexington

Repair—Renewal—New Service Com. 12-29-52


Date	Material	Amount	Total	Date	Amount
12/19/52	Labor	1 63		12-4-54 Deposited	25 00
	10% overhead	15	1 79	12-29-54 Refunded	1 19 16
	45' - 3/4" Copper Tubing @ .34	15 30			21 94
	1-3/4" Cx 1 W.F. Stop & Waste	4 00			
	1 hr. trucking		75		
			21 84	12/19/52 Labor	1 63
				12' - 3/4" Copper Tubing @ .34	4 08
				1-3/4" C. Corp-cock	4 33
				1-3/4" Cx 3/4" Curb-cock	4 67
				1-Box & Red	3 90
				1-1/2 Straight Tail Piece	50
				1-1/2 of Curb Tail Piece	50
				1 hr trucking	75
					20 36

DATE \_\_\_\_\_

TOWN OF LEXINGTON — BOARD OF PUBLIC WORKS

**WATER DIVISION**

Sketch of Service Here

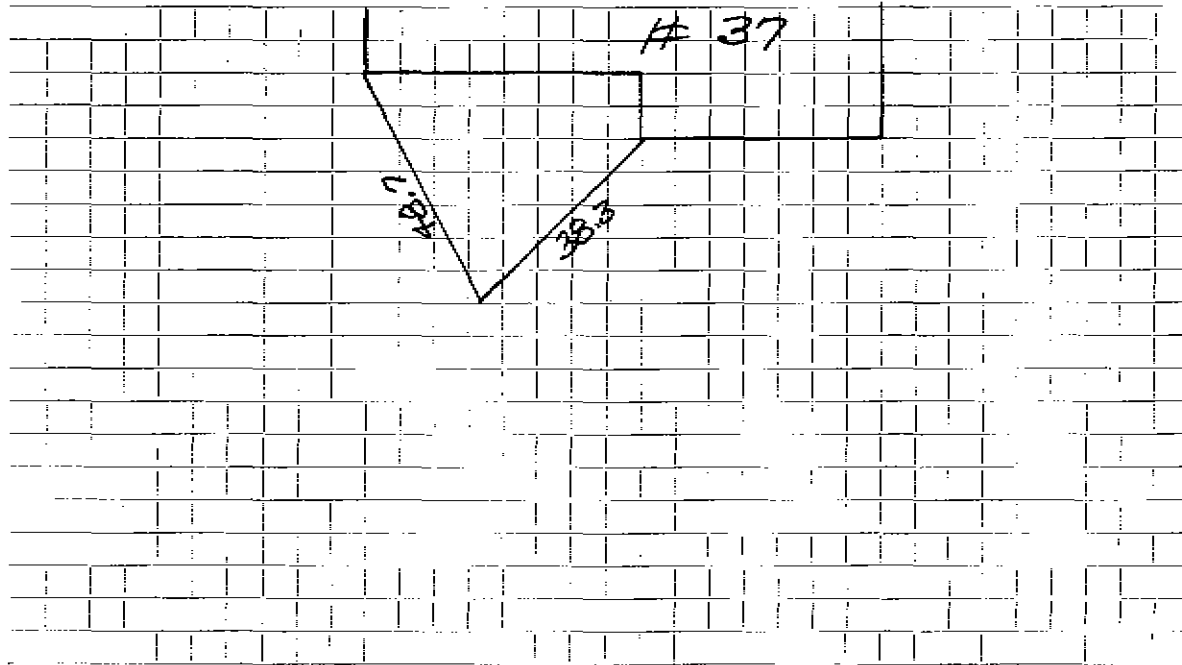

Connection made in ..... Street. Work completed .....

Remarks: .....  
.....  
.....