

WATER SERVICE RECORD

Name Charles E. Murray

Service No. 327

Address 10 Collidge Ave.

#2650

Location Lexington

Repair ~~Renewal~~ **New Service** Com. 12-29-52


Date	Material	Amount	Total	Date	Amount
12/18/52	Labor	1 53		12-5-52 Deposited	25 00
	10% overhead	16	1 79	12-29-52 Refunded	(4 52
	41'-3/4" Copper Tubing @.31		13 94		NON-CHARGE
	1-3/4" Ox I.W.H. Stop & Waste		4 00	12/18/52 labor	1 63
	1 Hr. Trucking		75	26'-3/4" Copper Tubing @.31	8 84
			20 48	1-3/4" C. Curb-cock	4 33
				1-3/4" Ox 3/4" C. Curb-cock	4 67
				1-Box & Rod	3 90
				1-1/2" Straight Tail Piece	50
				1-1/2" offset Tail Piece	50
				1 hr. trucking	75
					25 12

DATE _____

TOWN OF LEXINGTON — BOARD OF PUBLIC WORKS

WATER DIVISION

Sketch of Service Here

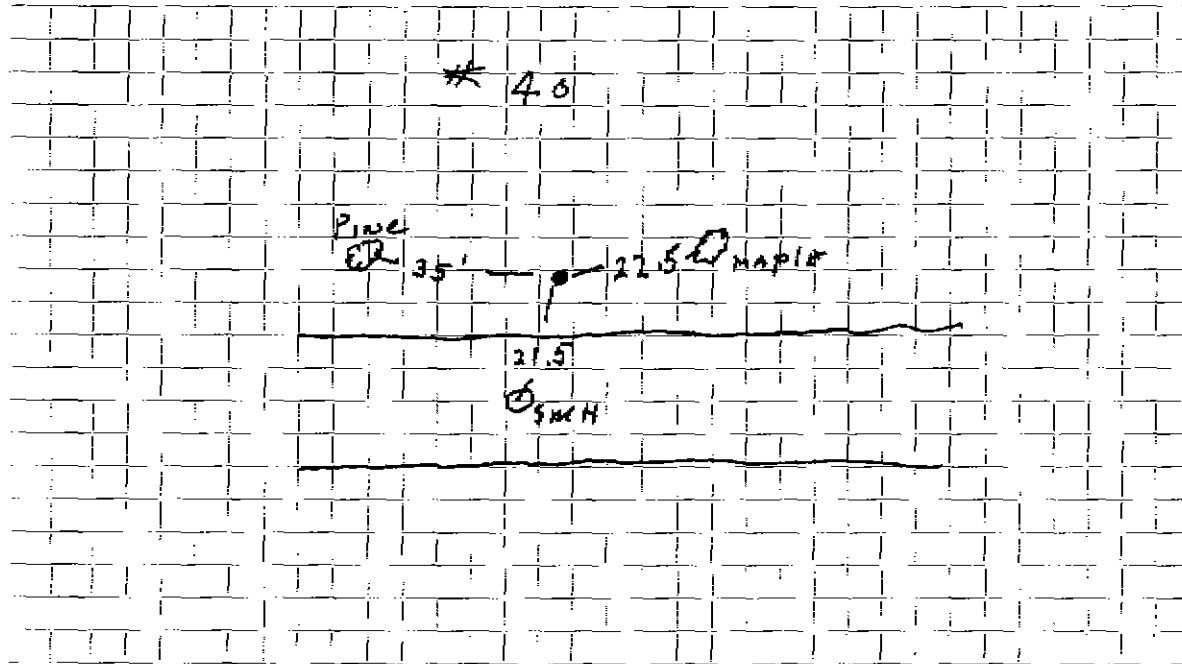

Connection made in Street. Work completed

Remarks: HOUSE TORN DOWN 10/97

.....

.....