

WATER SERVICE RECORD

Name **Emile Saulnier**

Service No. **130**

Address **43 Coolidge Ave.**

Location **Lexington**

~~NEW SERVICE~~ **New Service**

P
6 m. 9-22-52


Date	Material	Amount	Total	Date	Amount
8/13/52	Labor	1 63		7-7-52 Deposited	25 -
	10% overhead	16	1 79	9-22-52 Refunded	(2 98)
	45' - 3/4" copper tubing@ .3439	15 48		<u>NON CHARGE</u>	22 02
	1 - 3/4" C x 1/2 I.W.H. stop & waste	4 00		8/13/52 Labor	1 63
	1 hr. trucking		75	10' - 3/4" copper tubing@ .3439	3 44
			22 02	1 - 3/4" C corp-cock	4 33
				1 - 3/4" C x 3/4" C. curb-cock	4 67
				1 - box and rod	3 90
				1 - 1/2 straight tail piece	50
				1 - 1/2 offset tail piece	50
				1 hr. trucking	75
					19 72

DATE _____

TOWN OF LEXINGTON — BOARD OF PUBLIC WORKS

WATER DIVISION

Sketch of Service Here

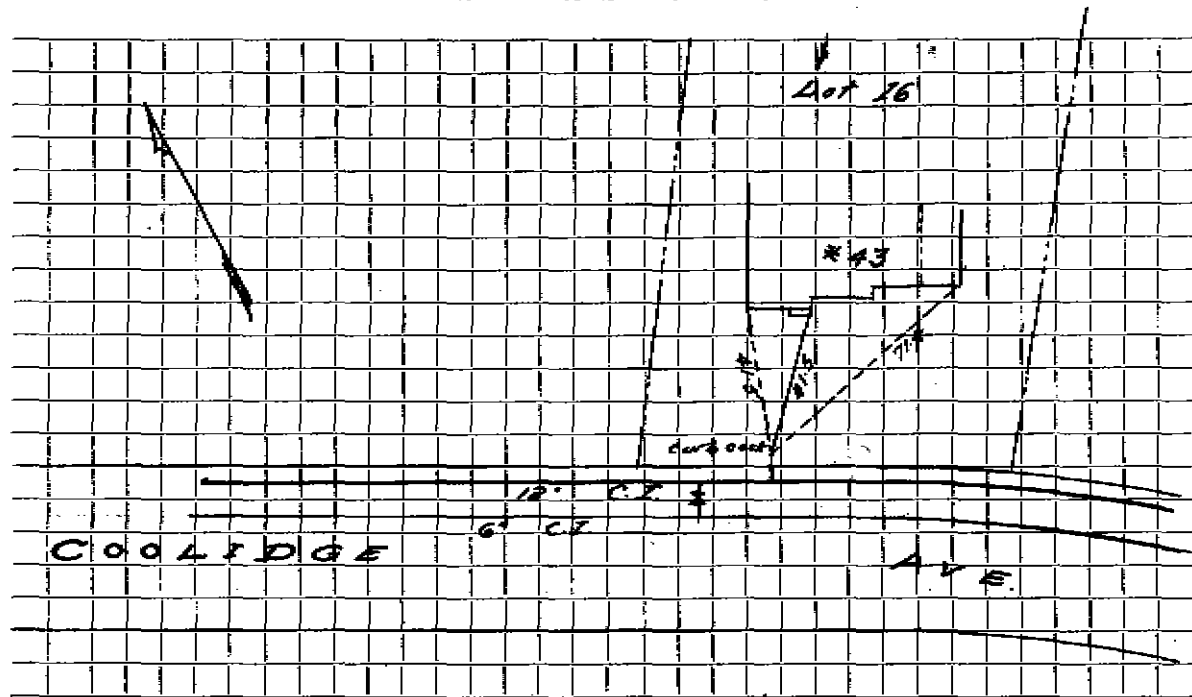

Connection made in Street. Work completed

Remarks:

.....

.....