

Floca M. Guinan

WATER SERVICE RECORD

3591 # 6997

Name ~~Emile Saulnier~~

Service No. 6

Address 46 Coolidge Ave.

Location Lexington

~~Repair Renewal~~ New Service

COM.2-16-53


Date	Material	Amount	Total	Date	Amount
1/30/53	Labor	1 63		1-8-53 Deposited	25 00
	10% overhead	16	1 79	2-16-53 Refunded	(2 48)
	47' - 3/4" Copper Tubing @ .31		15 98		NON CHARGE
	1-3/4" C x 1/2 I.W.H. stop & waste		4 00	1/30/53 Labor	1 63
	1 Hr. Trucking		75	28' - 3/4" Copper Tubing @ .34	9 52
			22 52	1-3/4" C. Corp-cock	4 33
				1-3/4" C x 3/4" C. Curb-cock	4 67
				1-Box & Red	3 90
				1-1/2 offset Tail Piece	50
				1-1/2 Straight tail piece	50
				1 Hr Trucking	75
					25 80

DATE _____

TOWN OF LEXINGTON — BOARD OF PUBLIC WORKS

WATER DIVISION

Sketch of Service Here

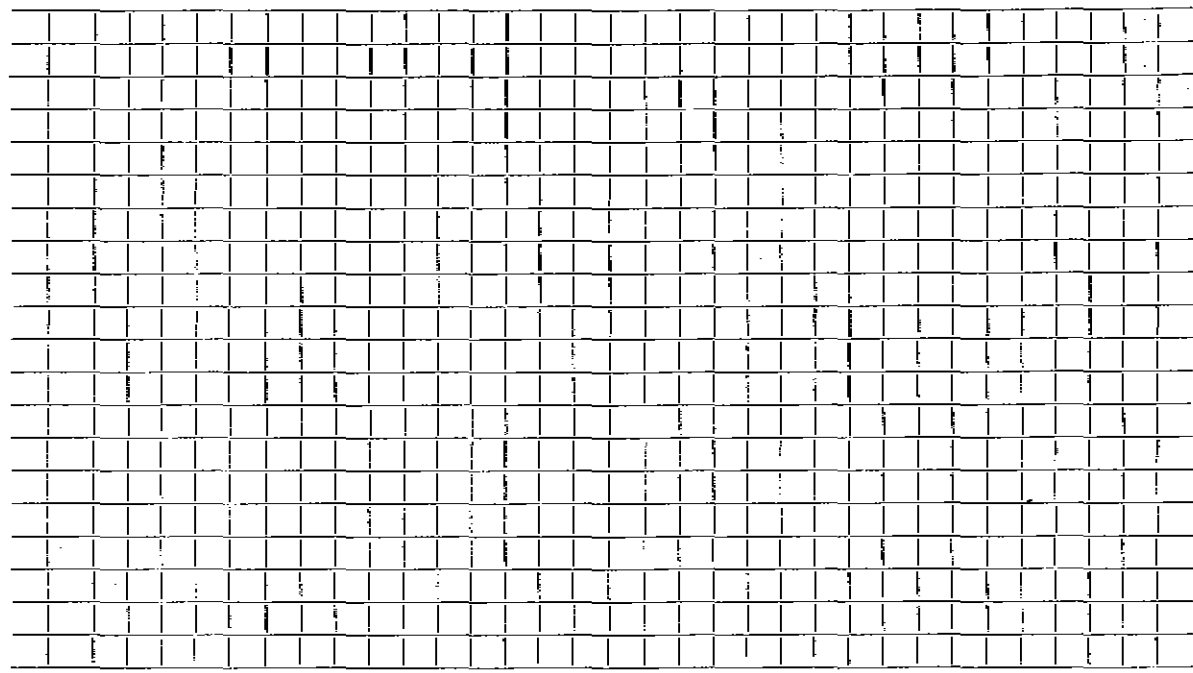

Connection made in Street. Work completed

Remarks:
.....
.....