

## WATER SERVICE RECORD

Name Mark Moore, Jr.

Service No. 47

Address 47 Coolidge Ave.

Location Lexington

~~REPAIR WORK~~—New Service Com. 3/30/53


Date	Material	Amount	Total	Date	Amount
3/16/53	Labor	1 63		3-5-53	25 -
	10% overhead	16	1 79	3-30-53	(3) 16
	45' - 3/4" copper tubing @ .34	.34	15 30		21 84
	1 - 3/4" C x 1/2 I.W.H. stop & waste	4 00		3/16/53	Labor
	1 hr. trucking		75		1 63
			21 84		10' - 3/4" copper tubing @ .34
					3 40
					1 - 3/4" C. corp-cock
					4 33
					1 - 3/4" C x 3/4" C. curb-cock
					4 67
					1 - box and rod
					3 90
					1 - 1/2 straight tail piece
					50
					1 - 1/2 offset tail piece
					50
					1 hr. trucking
					75
					19 68

DATE \_\_\_\_\_

# TOWN OF LEXINGTON — BOARD OF PUBLIC WORKS

## WATER DIVISION

Sketch of Service Here

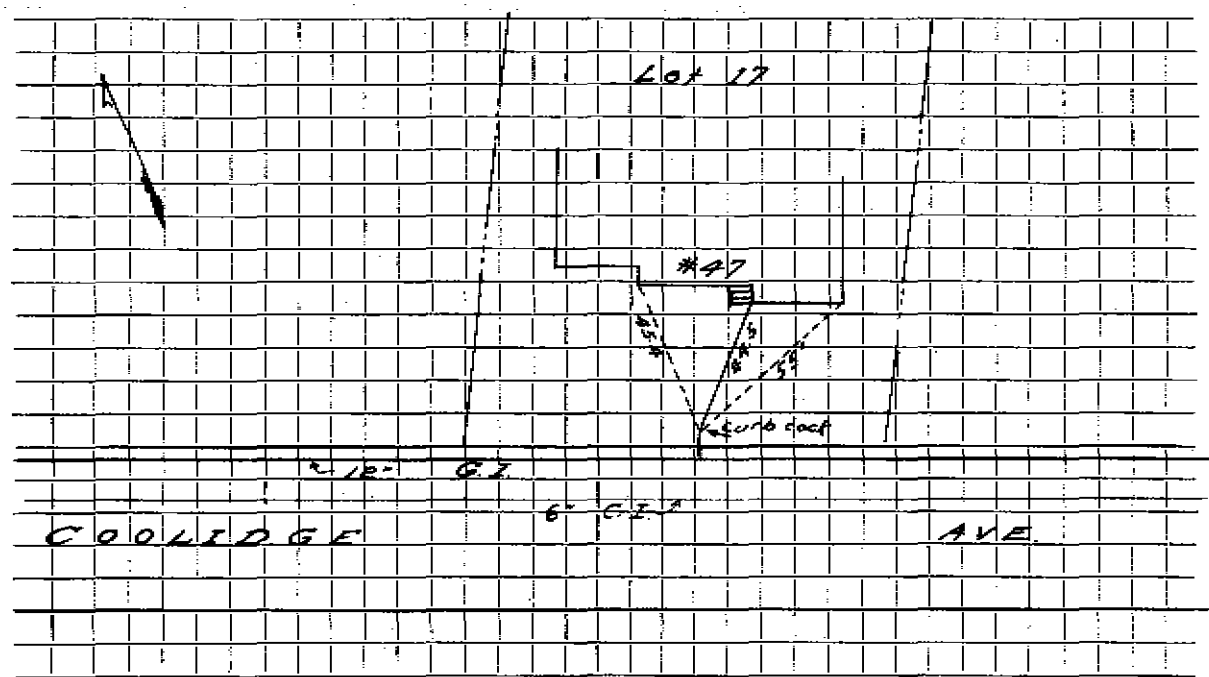

Connection made in ..... Street. Work completed .....

Remarks: .....

.....

.....