

WATER SERVICE RECORD

1361
Service No.

67

Name Louis Stoico Inc.

Address 48 Coolidge Avenue

Location

~~Water Service~~ - New Service W.O. #8076

Comm 10-28-63


Date	Material	Amount	Total	Date		Amount
8-19-63	Labor	2 42		7-19-63	Deposit	100 00
	10% O.H.	24	2 66	10-28-63	Refund	57 26
	75' 3/4" Copper Tubing @ .42		31 50			43 54
	1 3/4" C x 1/2" I.W.H. Stop & Waste		6 17			
	1 3/4" C 3 part Union		2 41		NON CHARGE	
			42 74		Labor	2 31
					38' 3/4" Cop. tubing @ .42	15 96
					1 3/4" C. Corp Cock	4 91
					1 3/4" C Curb Cock	6 28
					1 Box & Rod	4 90
					1/2 straight Tail piece	50
					1/2 offset Tail piece	50
						85 36

DATE _____

TOWN OF LEXINGTON — BOARD OF PUBLIC WORKS

WATER DIVISION

Sketch of Service Here

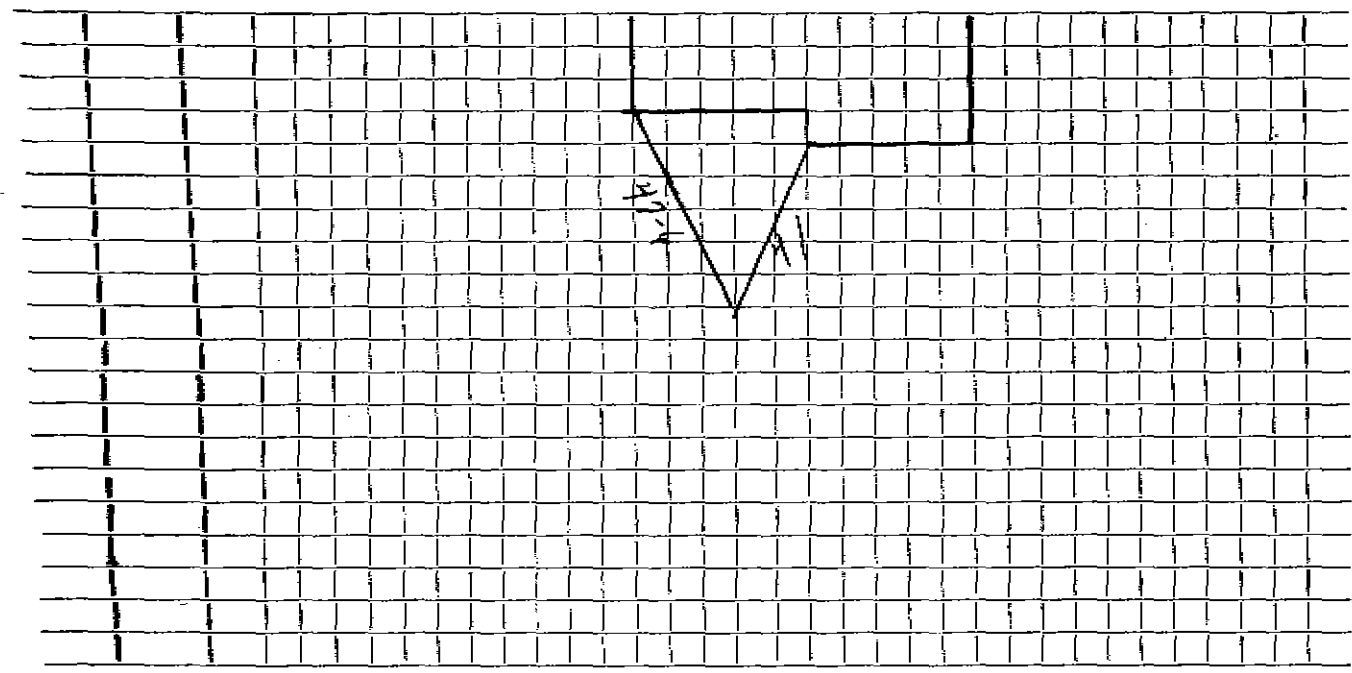

Connection made in Street. Work completed

Remarks:
.....
.....