

Name Joseph Napoli  
 Address 5 Coolidge Avenue  
 Lexington

Service No. 81

Location 5 Coolidge Avenue #3560

Kind of Pipe Size Size of Main

~~Repair - Renewal~~ - New Service Com. 7-3-50

Location

Date	Material	Amount	Total	Date	Material	Amount
May 31 '50	Labor		1 30	May 31 '50	Labor	1 30
	10% Overhead		13			
	35' - 3/4" Copper Tubing @ 23¢		8 05	July 30 '50		
	1 - 3/4" C x 1/2" I.W.H. S&W		3 29			
	1 hr. Trucking		75			
			13 52			
				May 31 '50	Labor	1 30
					15' - 3/4" Copper Tubing @ 23¢	3 45
					1 - 3/4" C Corp-cock	3 15
					1 - 3/4" C x 3/4" C Curb-cock	3 85
					1 Box & Rod	3 35
					1 - 1/2" Offset Tail Piece	38
					1 - 1/2" Straight Tail Piece	38
					1 hr. Trucking	75
	Labor					16 61

*May 31 '50 Deposited*  
*July 30 '50*

No Charge

Hadley Press, Inc., Lexington

## TOWN OF LEXINGTON—BOARD OF PUBLIC WORKS WATER DIVISION

The undersigned applies for a supply of water at No. \_\_\_\_\_ St. and hereby agrees to comply with the rules and regulations as now, or at any future time, established by the Board of Selectmen.

Am't. of Estimate \$ \_\_\_\_\_


Owner \_\_\_\_\_

Am't. Paid \$ \_\_\_\_\_

Address \_\_\_\_\_  
\_\_\_\_\_

Builder \_\_\_\_\_

Sketch of Service Here

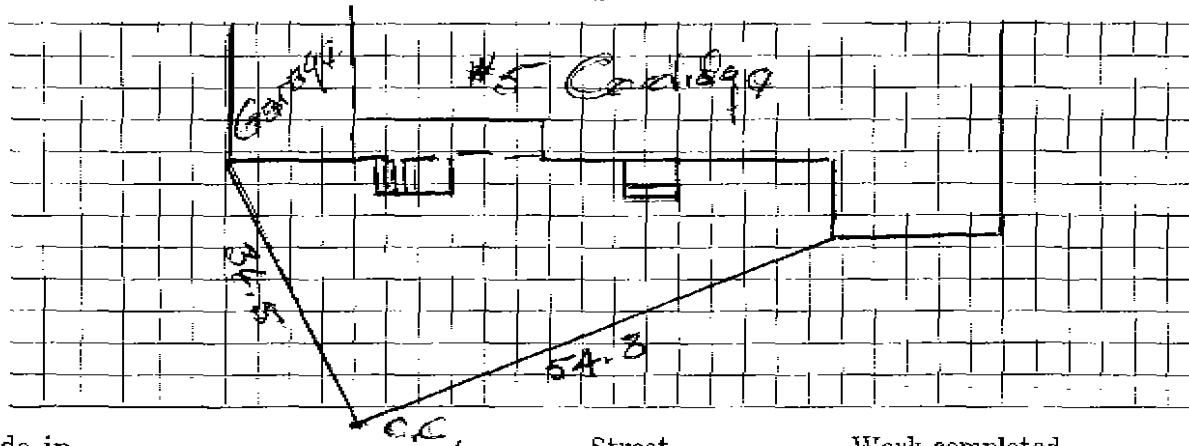

Connection made in \_\_\_\_\_ Street. Work completed \_\_\_\_\_ 19

Remarks: