

4823

WATER SERVICE RECORD

Name Louis Stoico

Service No. 132

Address 50 Coolidge Avenue

Location

~~Repair~~—~~Renewal~~—New Service

W. O. 8290 **MAR 23 1964**

Date	Material	Amount	Total	Date		Amount
11/29/63	Labor	2 42		1-5-63	Deposit	100 00
	10% Overhead	24	2 66	3-23-64	* Refund	59 36
	70' 3/4" Copper tubing @ .42		29 40			40 64
	1 3/4" Cx 1/2 I.W.H. Stop & Waste		6 17		NON CHARGE	
	1 3/4" C. 3-part Union		2 41		Labor	2 31
			40 64		38' 3/4" Copper tubing @ .42	15 96
					1 3/4" G. Corp Cock	4 91
					1 3/4" C. Curb Cock	6 28
					1 Box & Rod	4 90
					1 1/2 Straight tailpiece	50
					1 1/2 Offset tailpiece	50
						<u>35 36</u>


* Applied to SHC#169

DATE _____

TOWN OF LEXINGTON — BOARD OF PUBLIC WORKS

WATER DIVISION

Sketch of Service Here

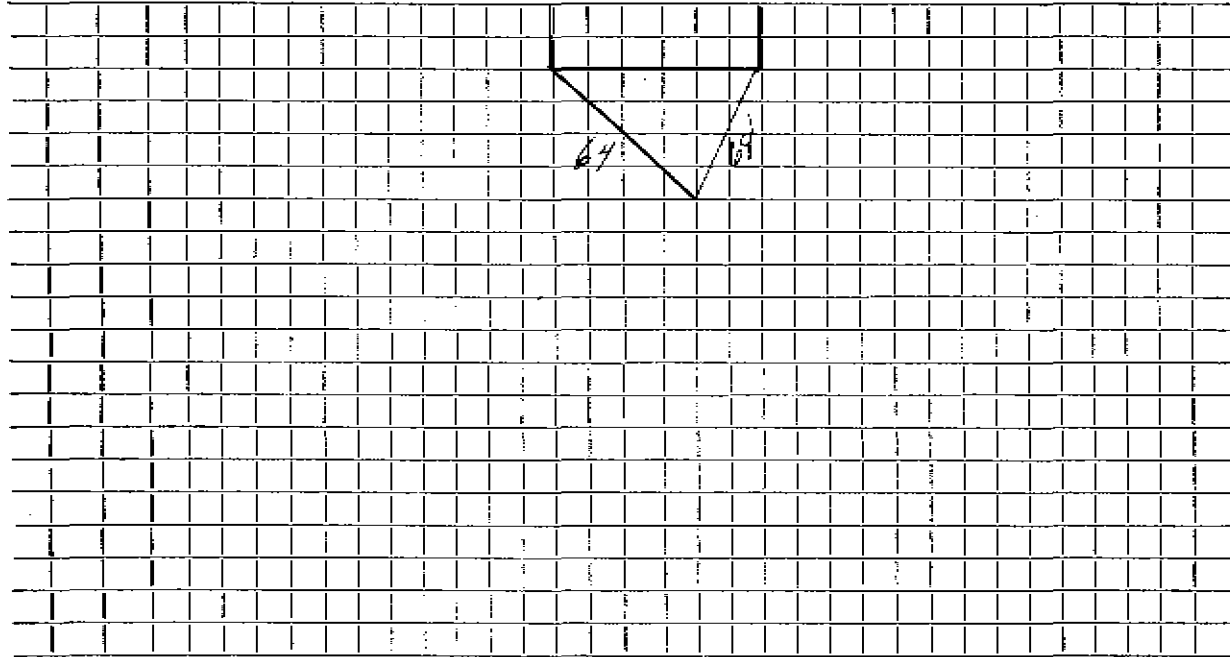

Connection made in Street. Work completed

Remarks:
.....
.....