

## WATER SERVICE RECORD

Name Pilgrim Congregational Church (Lester Andrews)

Service No. 7

Address 55 Coolidge Avenue

Location

~~Repair - Renewal~~ New Service

Comm 5-8-61


Date	Material	Amount	Total	Date		Amount
3-13-61	Labor	33.12		3-6-61	Deposit	300.00
	10% C.F.	3.31	36.43	5-8-61	* Refund	<u>4.56</u>
145'	2" Copper tubing @1.28		185.60			<u>295.44</u>
3	2" 3 part unions @14.27		42.81		NON CHARGE	
1	2" 2 part male Coupling		8.72	3-13-61	Labor	33.12
1	2" Brass Nipple		1.13	16'	2" Copper tubing @1.28	20.48
1	2" Comp Valve		14.75	1	2" C Corp Cock	22.98
2	hrs. Trucking @3.00		<u>6.00</u>	1	2" x 12" Service Saddle	12.63
			295.44	1	2" C.R. Seal Curb Cock	43.36
				1	Buffalo Box	<u>12.10</u>
						144.67

\* Applied to SHC#7

TOWN OF LEXINGTON — BOARD OF PUBLIC WORKS

**WATER DIVISION**

Sketch of Service Here

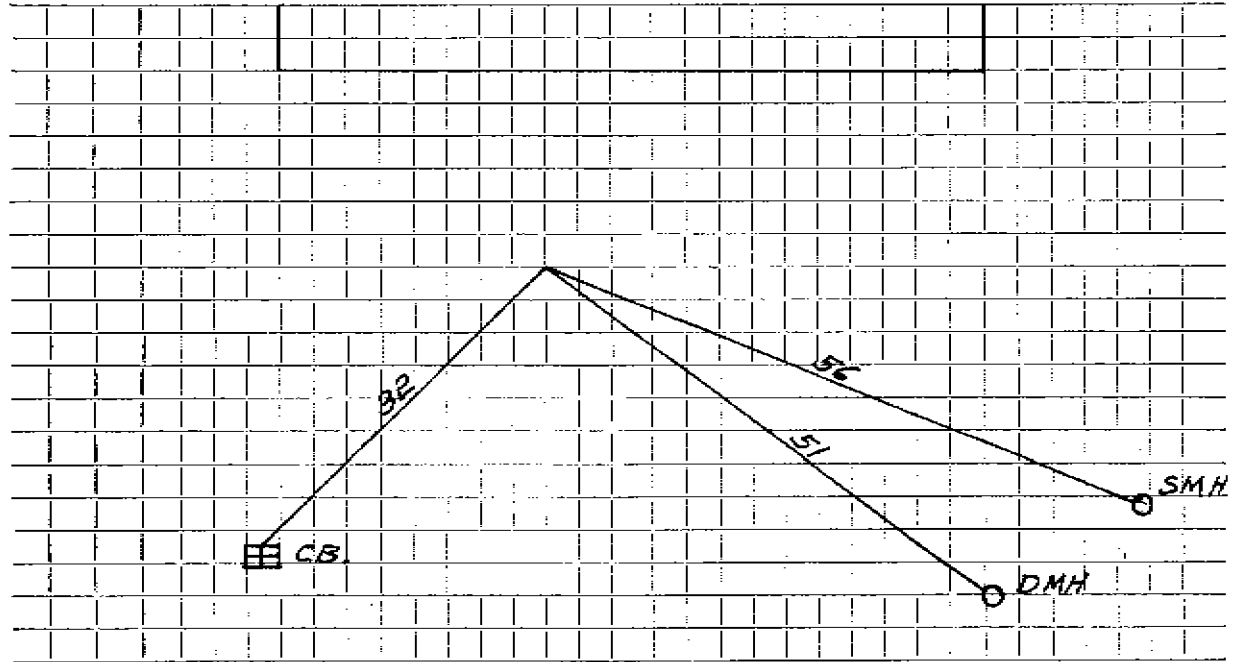

Connection made in ..... Street. Work completed .....

Remarks: .....

.....  
.....