

WATER SERVICE RECORD

5378

Name William H. Sullivan

Service No. 107

Address 56 Coolidge Avenue

Location

~~REPAIRS~~ New Service Russell Sibley Permit #A-48 W.O. #1124

MAR 14 1966


Date		Material	Amount	Total	Date	Amount
11-1-65		Labor	57 79		11-15-65	50 00
		10% O.H.	5 78	63 57	3-14-66	23 42
	42'	3/4" copper tubing @ .70		29 40	9-30-66	37 20
	1	Hr. Town Truck		3 00		110 22
	1	Hr. Compressor		5 00		
	1 1/2	Hr. Tractor @ 6.50		9 75		
				110 72		
11-3-65	38'	3/4" copper tubing				
						Bill sent 37.30

DATE _____

TOWN OF LEXINGTON — BOARD OF PUBLIC WORKS

WATER DIVISION

Sketch of Service Here

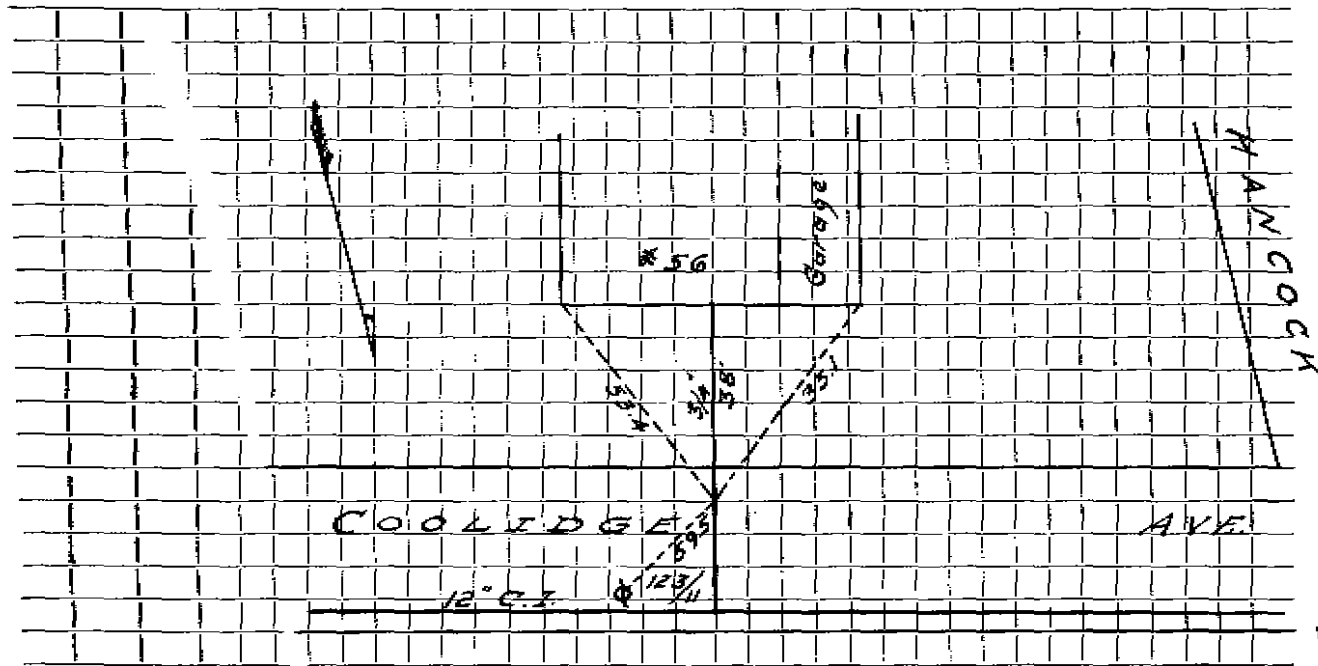

Connection made in Street. Work completed

Remarks:


.....

.....

DATE OCT 7 1999

TOWN OF LEXINGTON — BOARD OF PUBLIC WORKS
WATER DIVISION

Sketch of Service Here

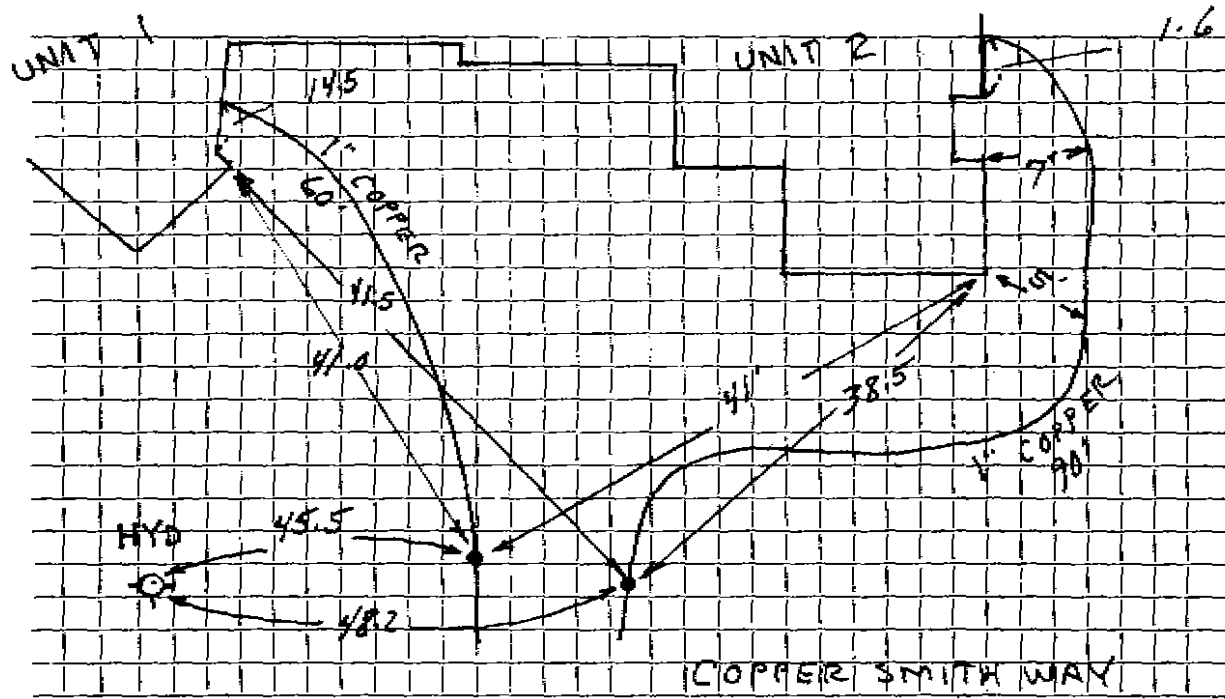

Connection made in COPPER SMITH WAY Street. Work completed

Remarks:

TSM