


DATE _____

TOWN OF LEXINGTON — BOARD OF PUBLIC WORKS

WATER DIVISION

Sketch of Service Here

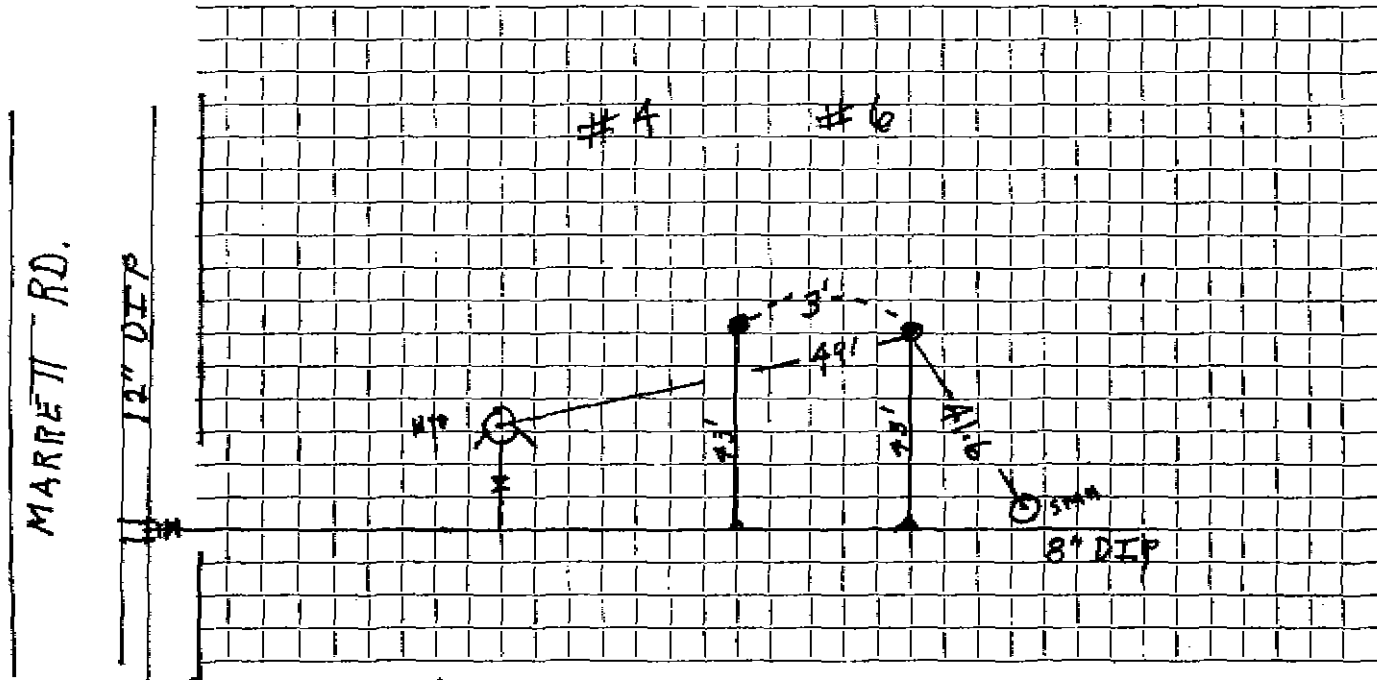

Connection made in MARRETT RD Street. Work completed

Remarks: 12 X 8 TAP 5 + GATE